




Production Notes:
 1. This map is for informational purposes only.
 2. Users are advised to use appropriate caution when using this information for navigation.
 3. The information shown on this map is not intended to be used for navigation.
 4. The information shown on this map is based on the best available data and is not guaranteed to be accurate.

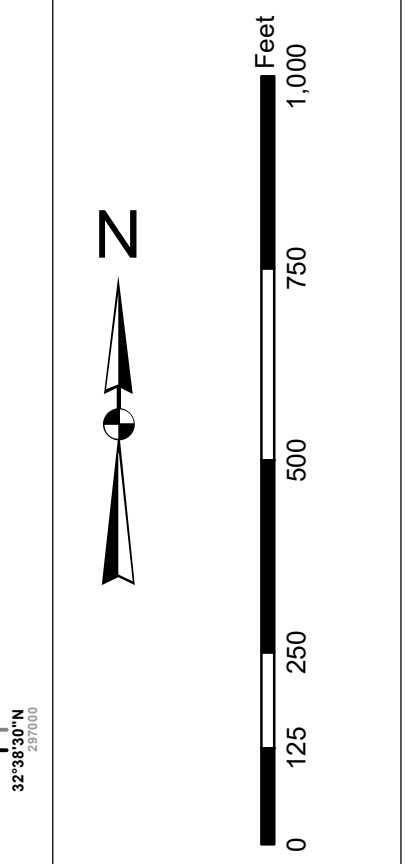

Legend


U.S. Army Corps of Engineers Charleston District Charleston, South Carolina Savannah Branch 800 MacLeod Ave Charleston, SC 29403 CESAC-GIS@USACE.ARMY.MIL	Designed By: lehydo Software v3.82 Reviewed By: Absolute State Reference State: T. 13,000 Scale: 1 inch = 250 feet Projection: NAD 1983 StatePlane South Carolina FIPS 3900 Feet Intl	Survey Date: 19 DEC 2017 Project Reference Number: 13000 Survey Station: CONDITION	Production Date: 27 DEC 2017
---	---	--	------------------------------

Charleston Entrance Channel Survey
 The information depicted on this map represents the results of surveys made on the dates indicated and is not intended to be used for navigation. The information shown on this map is based on the best available data and is not guaranteed to be accurate. Users are advised to use appropriate caution when using this information for navigation. No warranty is made for the use of this information for navigation.

Charleston, South Carolina
 Concluded on: 19 DEC 2017

51

53

49
R "4"
FIR 4s

54

51

52

G "3"
FIG 4s

Fort Sumter Reach

51

48

R "2"
FIR 2.5s


52

51

G "1"
FIG 2.5s


48

49

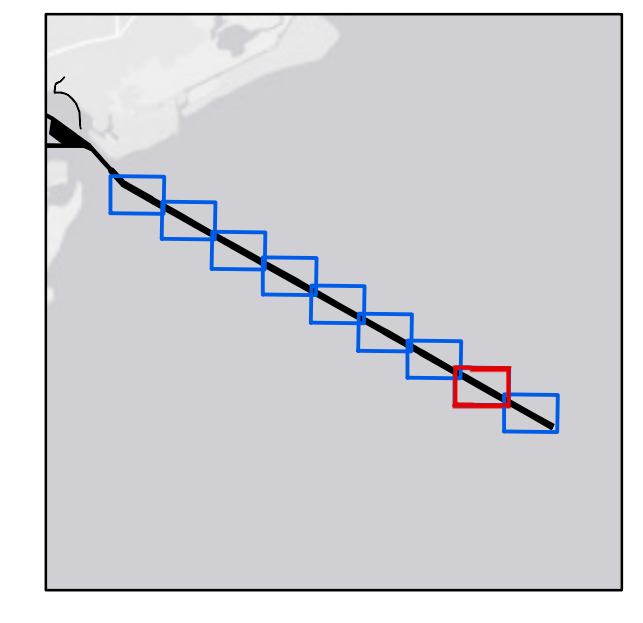





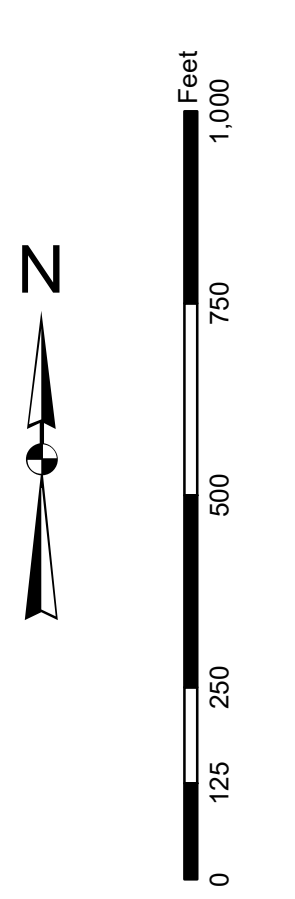


Legend

- Water**
 - Dark Blue
 - Light Blue
 - White
- Channel**
 - Blue
 - Light Blue
 - White


Designed By: Hydro Software v3.82	Survey Date: 19 DEC 2017	Production Date: 27 DEC 2017
Reviewed By: Absolute Scale 1:10,000	Project Reference Number: SAC-2017-00010	
Scale: 1 inch = 250 feet	Survey Station: CONDITION	
Projection: NAD 1983 StatePlane South Carolina FIPS 3800 Feet Intl		

Charleston Entrance Channel Survey
The information depicted on this map represents the results of surveys made on the dates indicated and is not intended to be used for general purposes. No warranty is made by the U.S. Army Corps of Engineers as to the accuracy or reliability of the data or as to the results of their use. The user is advised to verify the data and to use appropriate safety measures.
Concluded on: 19 DEC 2017
Charleston, South Carolina

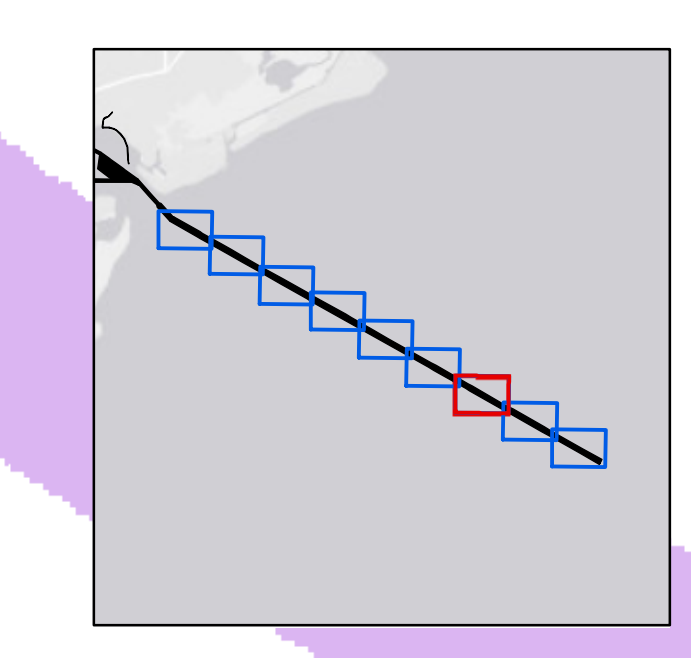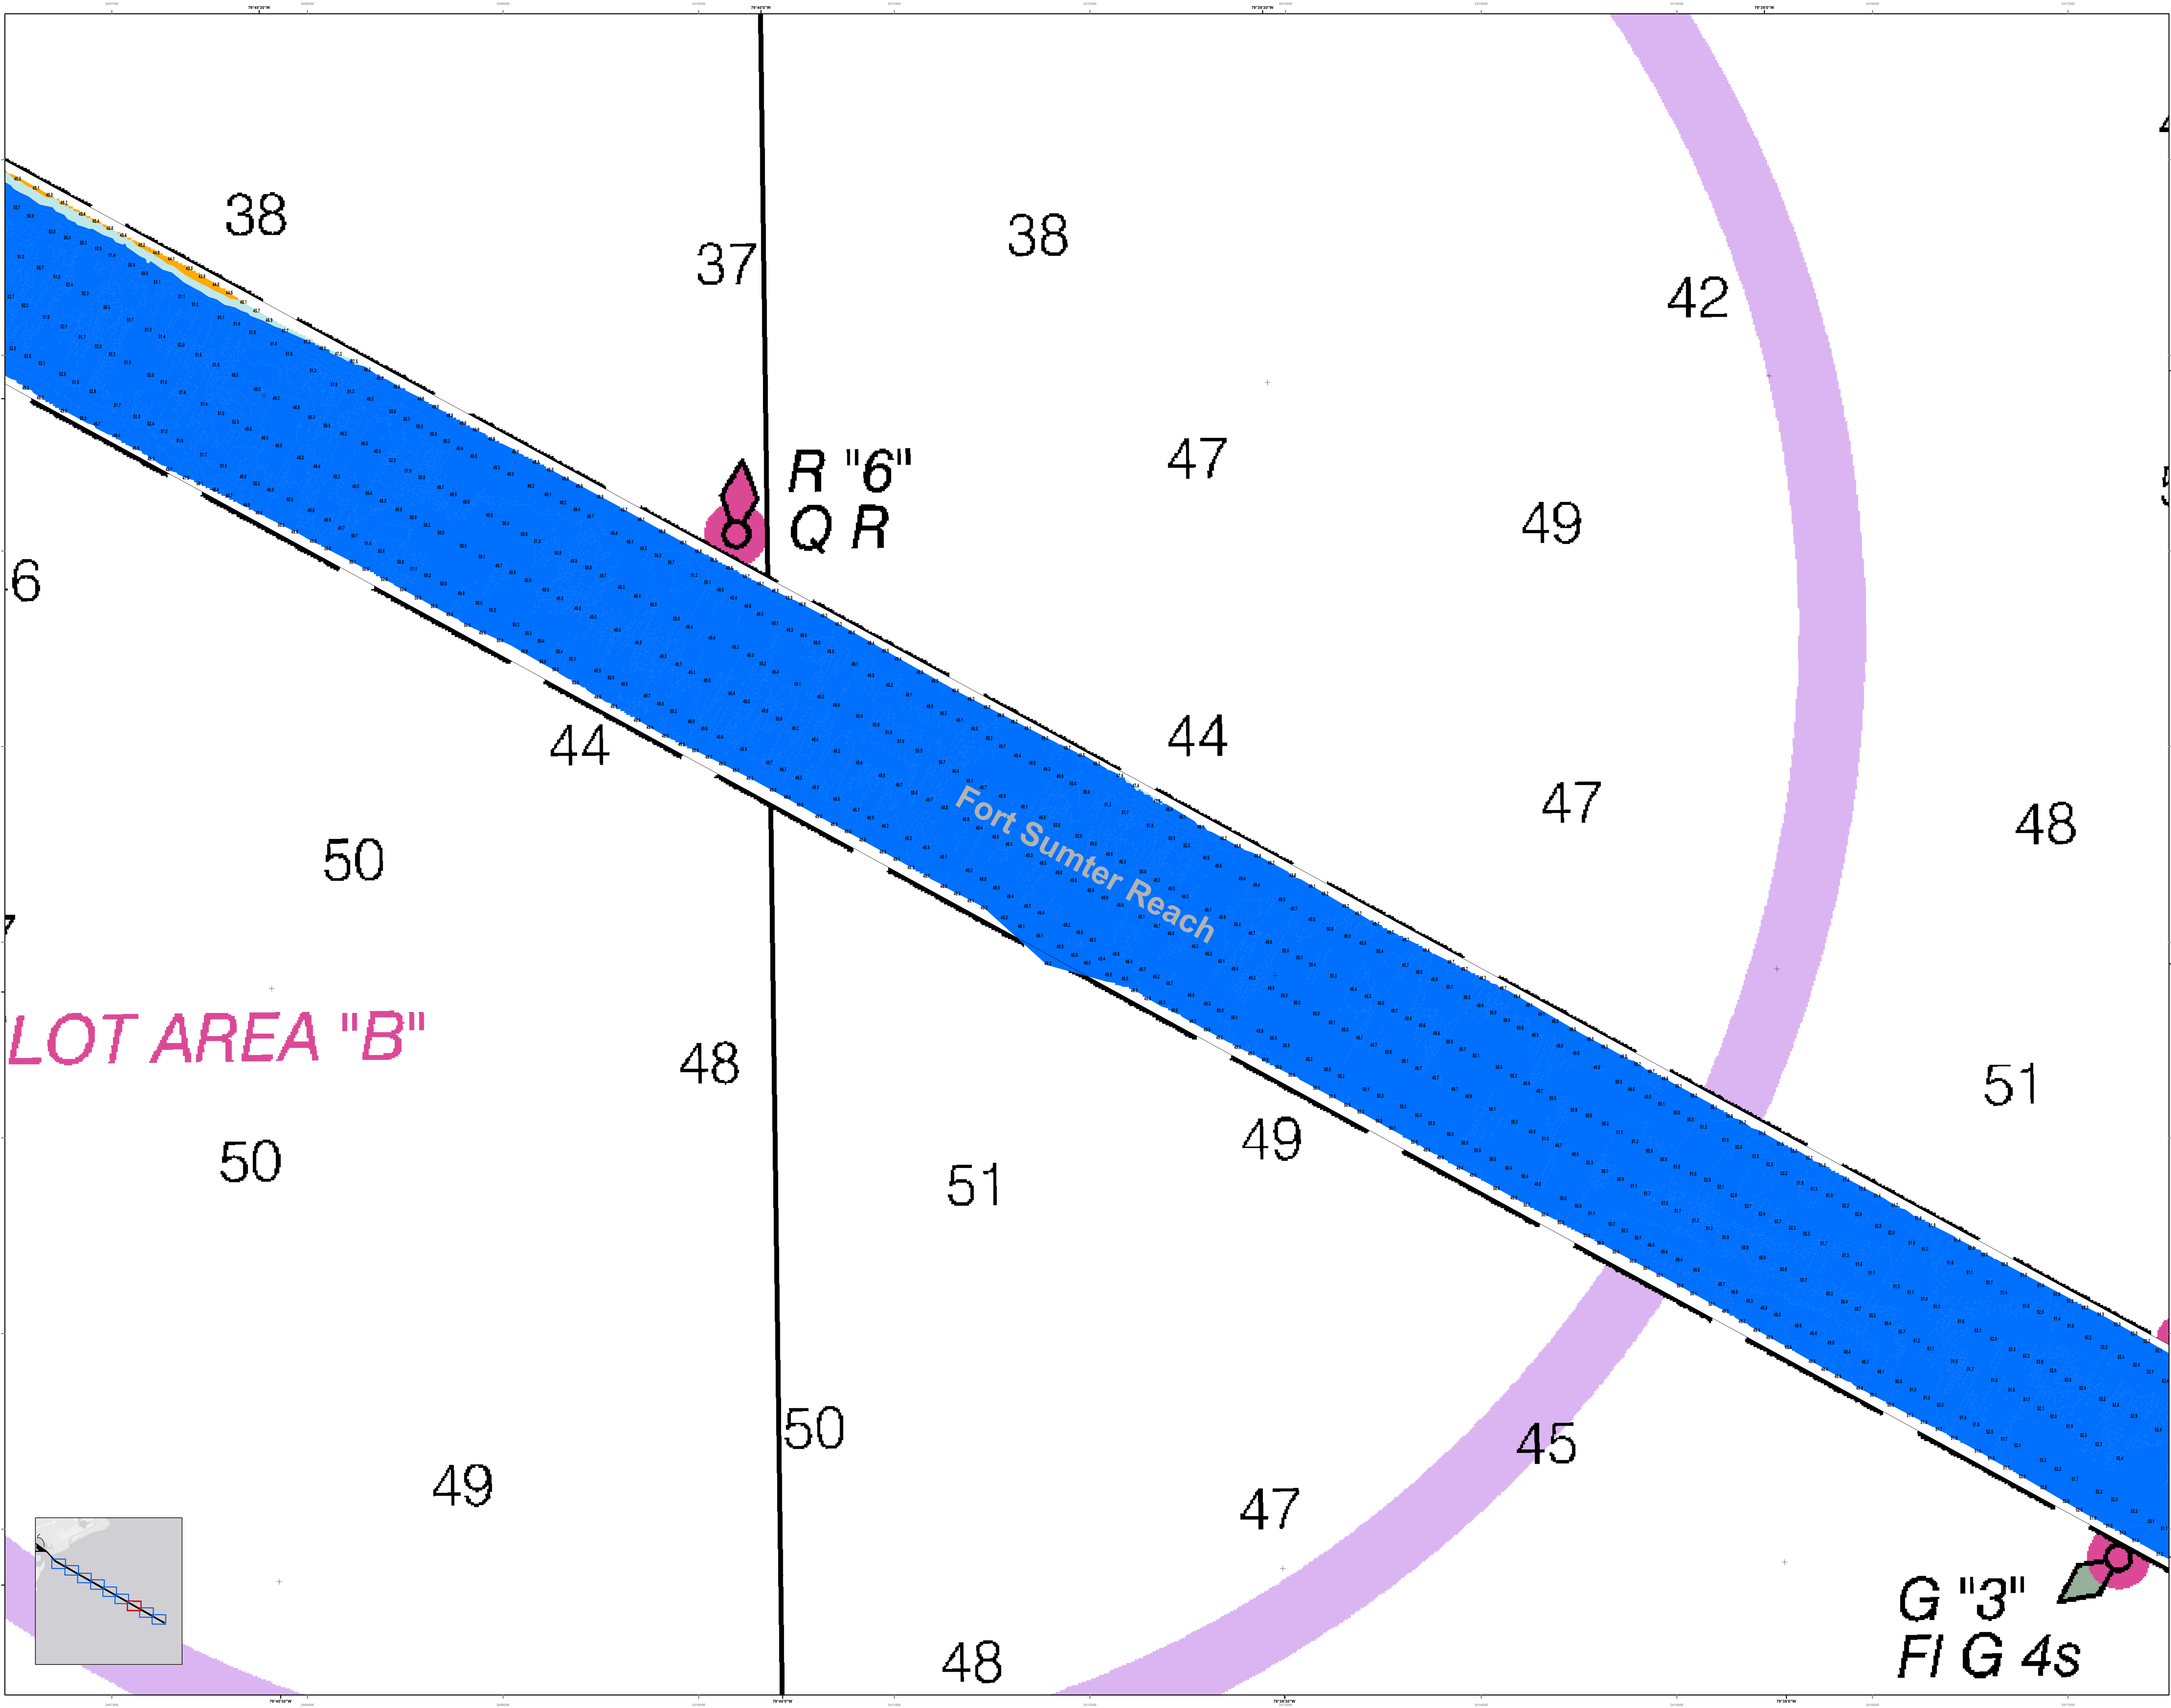



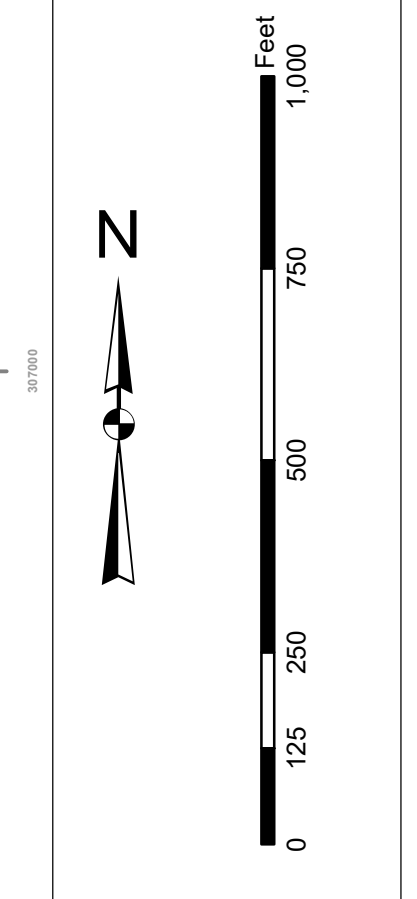








Designed By: Hydro Software v3.82	Reviewed By: 1:50,000	Scale: 1 inch = 250 feet	Projection: NAD 1983 StatePlane South Carolina FIPS 3800 Feet Intl
Survey Date: 19 DEC 2017	Project Reference Number: PC00010	Survey Station: CONDITION	Production Date: 27 DEC 2017
U.S. Army Corps of Engineers Charleston District Office Savannah Branch 800 MacLeod Ave Charleston, SC 29403	CESAC-GIS@USACE.ARMY.MIL		

Charleston Entrance Channel Survey
 The information depicted on this map represents the results of surveys made on the dates indicated and is not to be used for navigation. The data and information contained herein are not to be used for navigation.

Concluded on: 19 DEC 2017
 Charleston, South Carolina

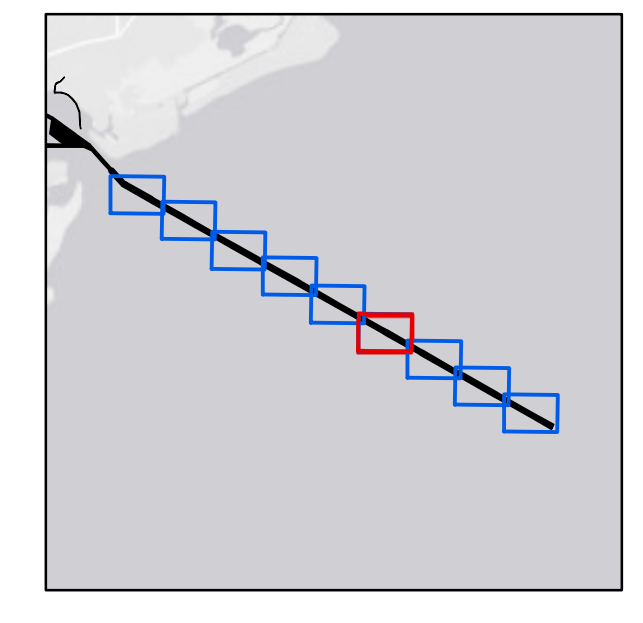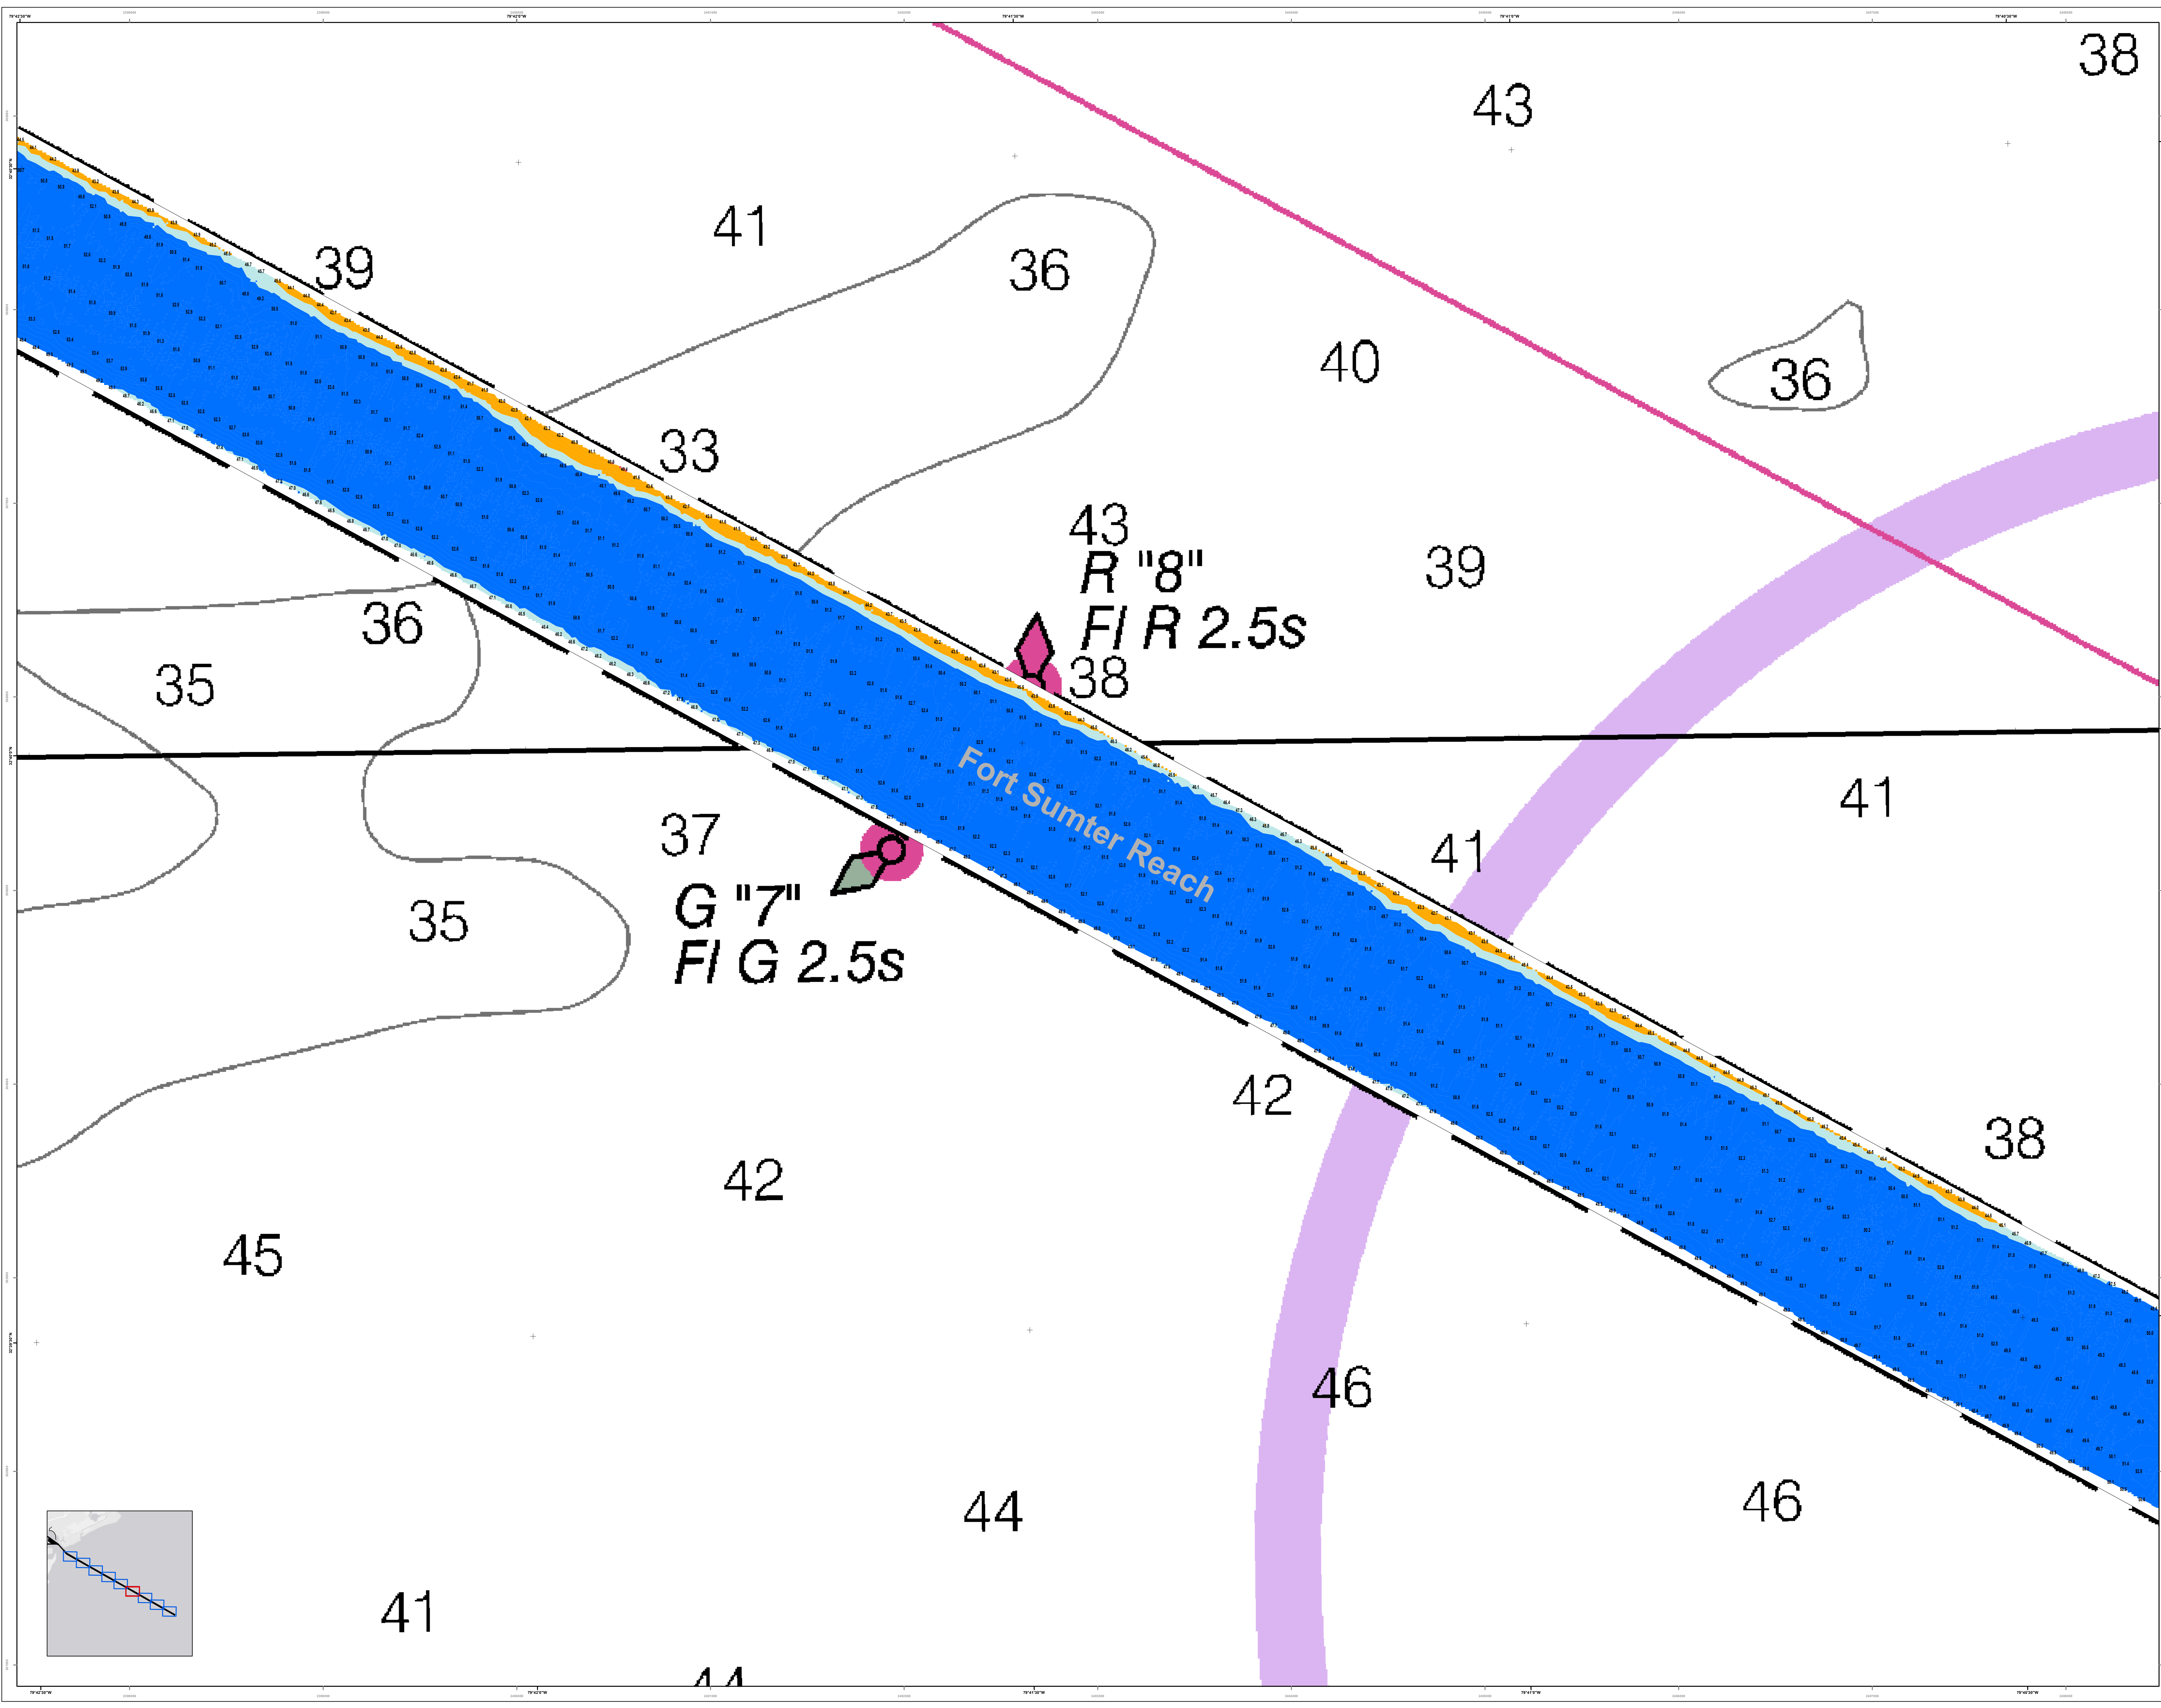

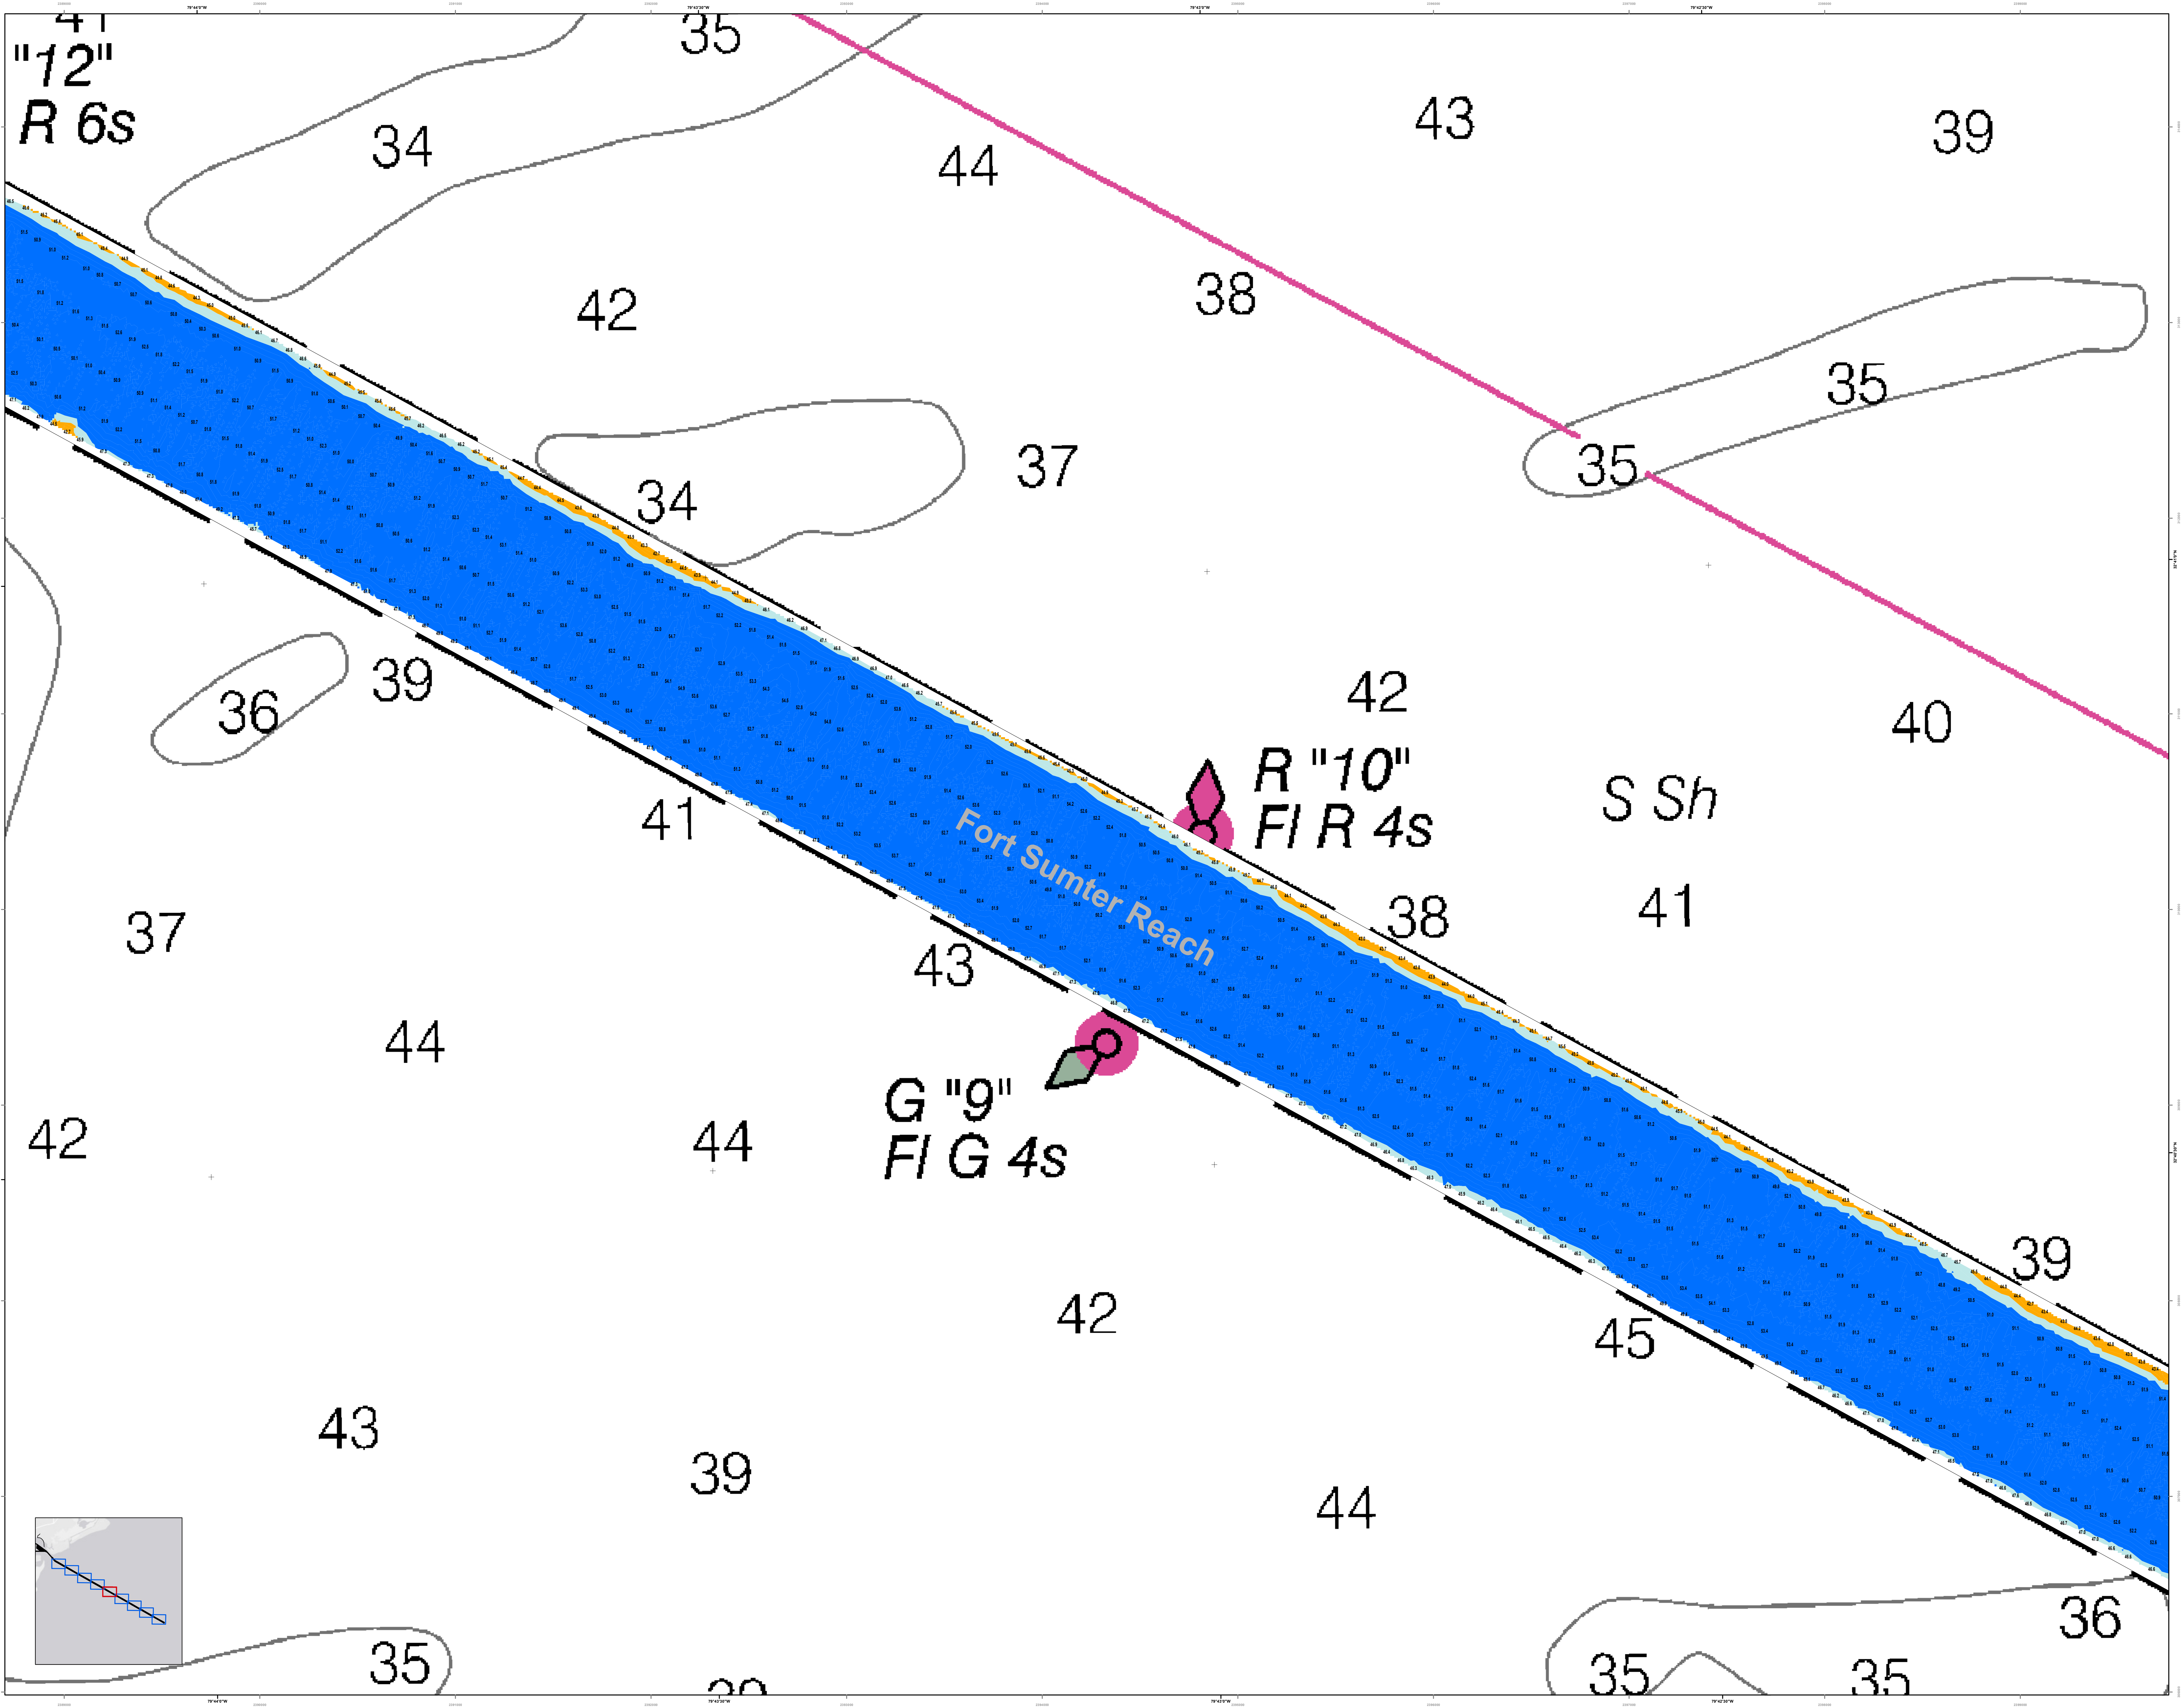


41
"12"
R 6s

R "10"
FIR 4s

G "9"
FIG 4s

S Sh

Fort Sumter Reach

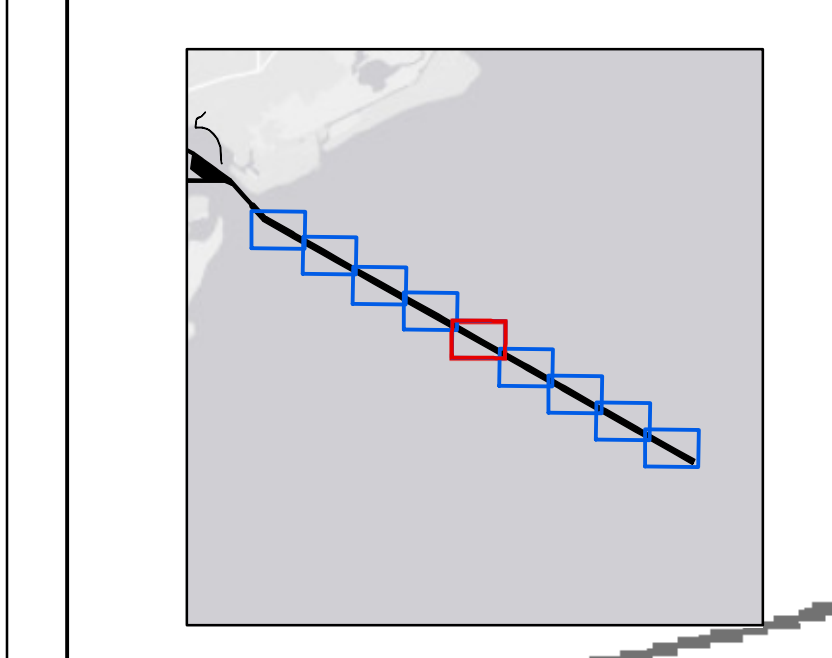

U.S. Army Corps of Engineers
Charleston District






Designed By: IHYDRO Software v3.82	Survey Date: 19 DEC 2017	Production Date: 27 DEC 2017
Projection: NAD 1983 StatePlane South Carolina FIPS 3800 Feet Intl		

U.S. Army Corps of Engineers
Charleston District
Charleston, South Carolina
Survey Station:
CONDITION

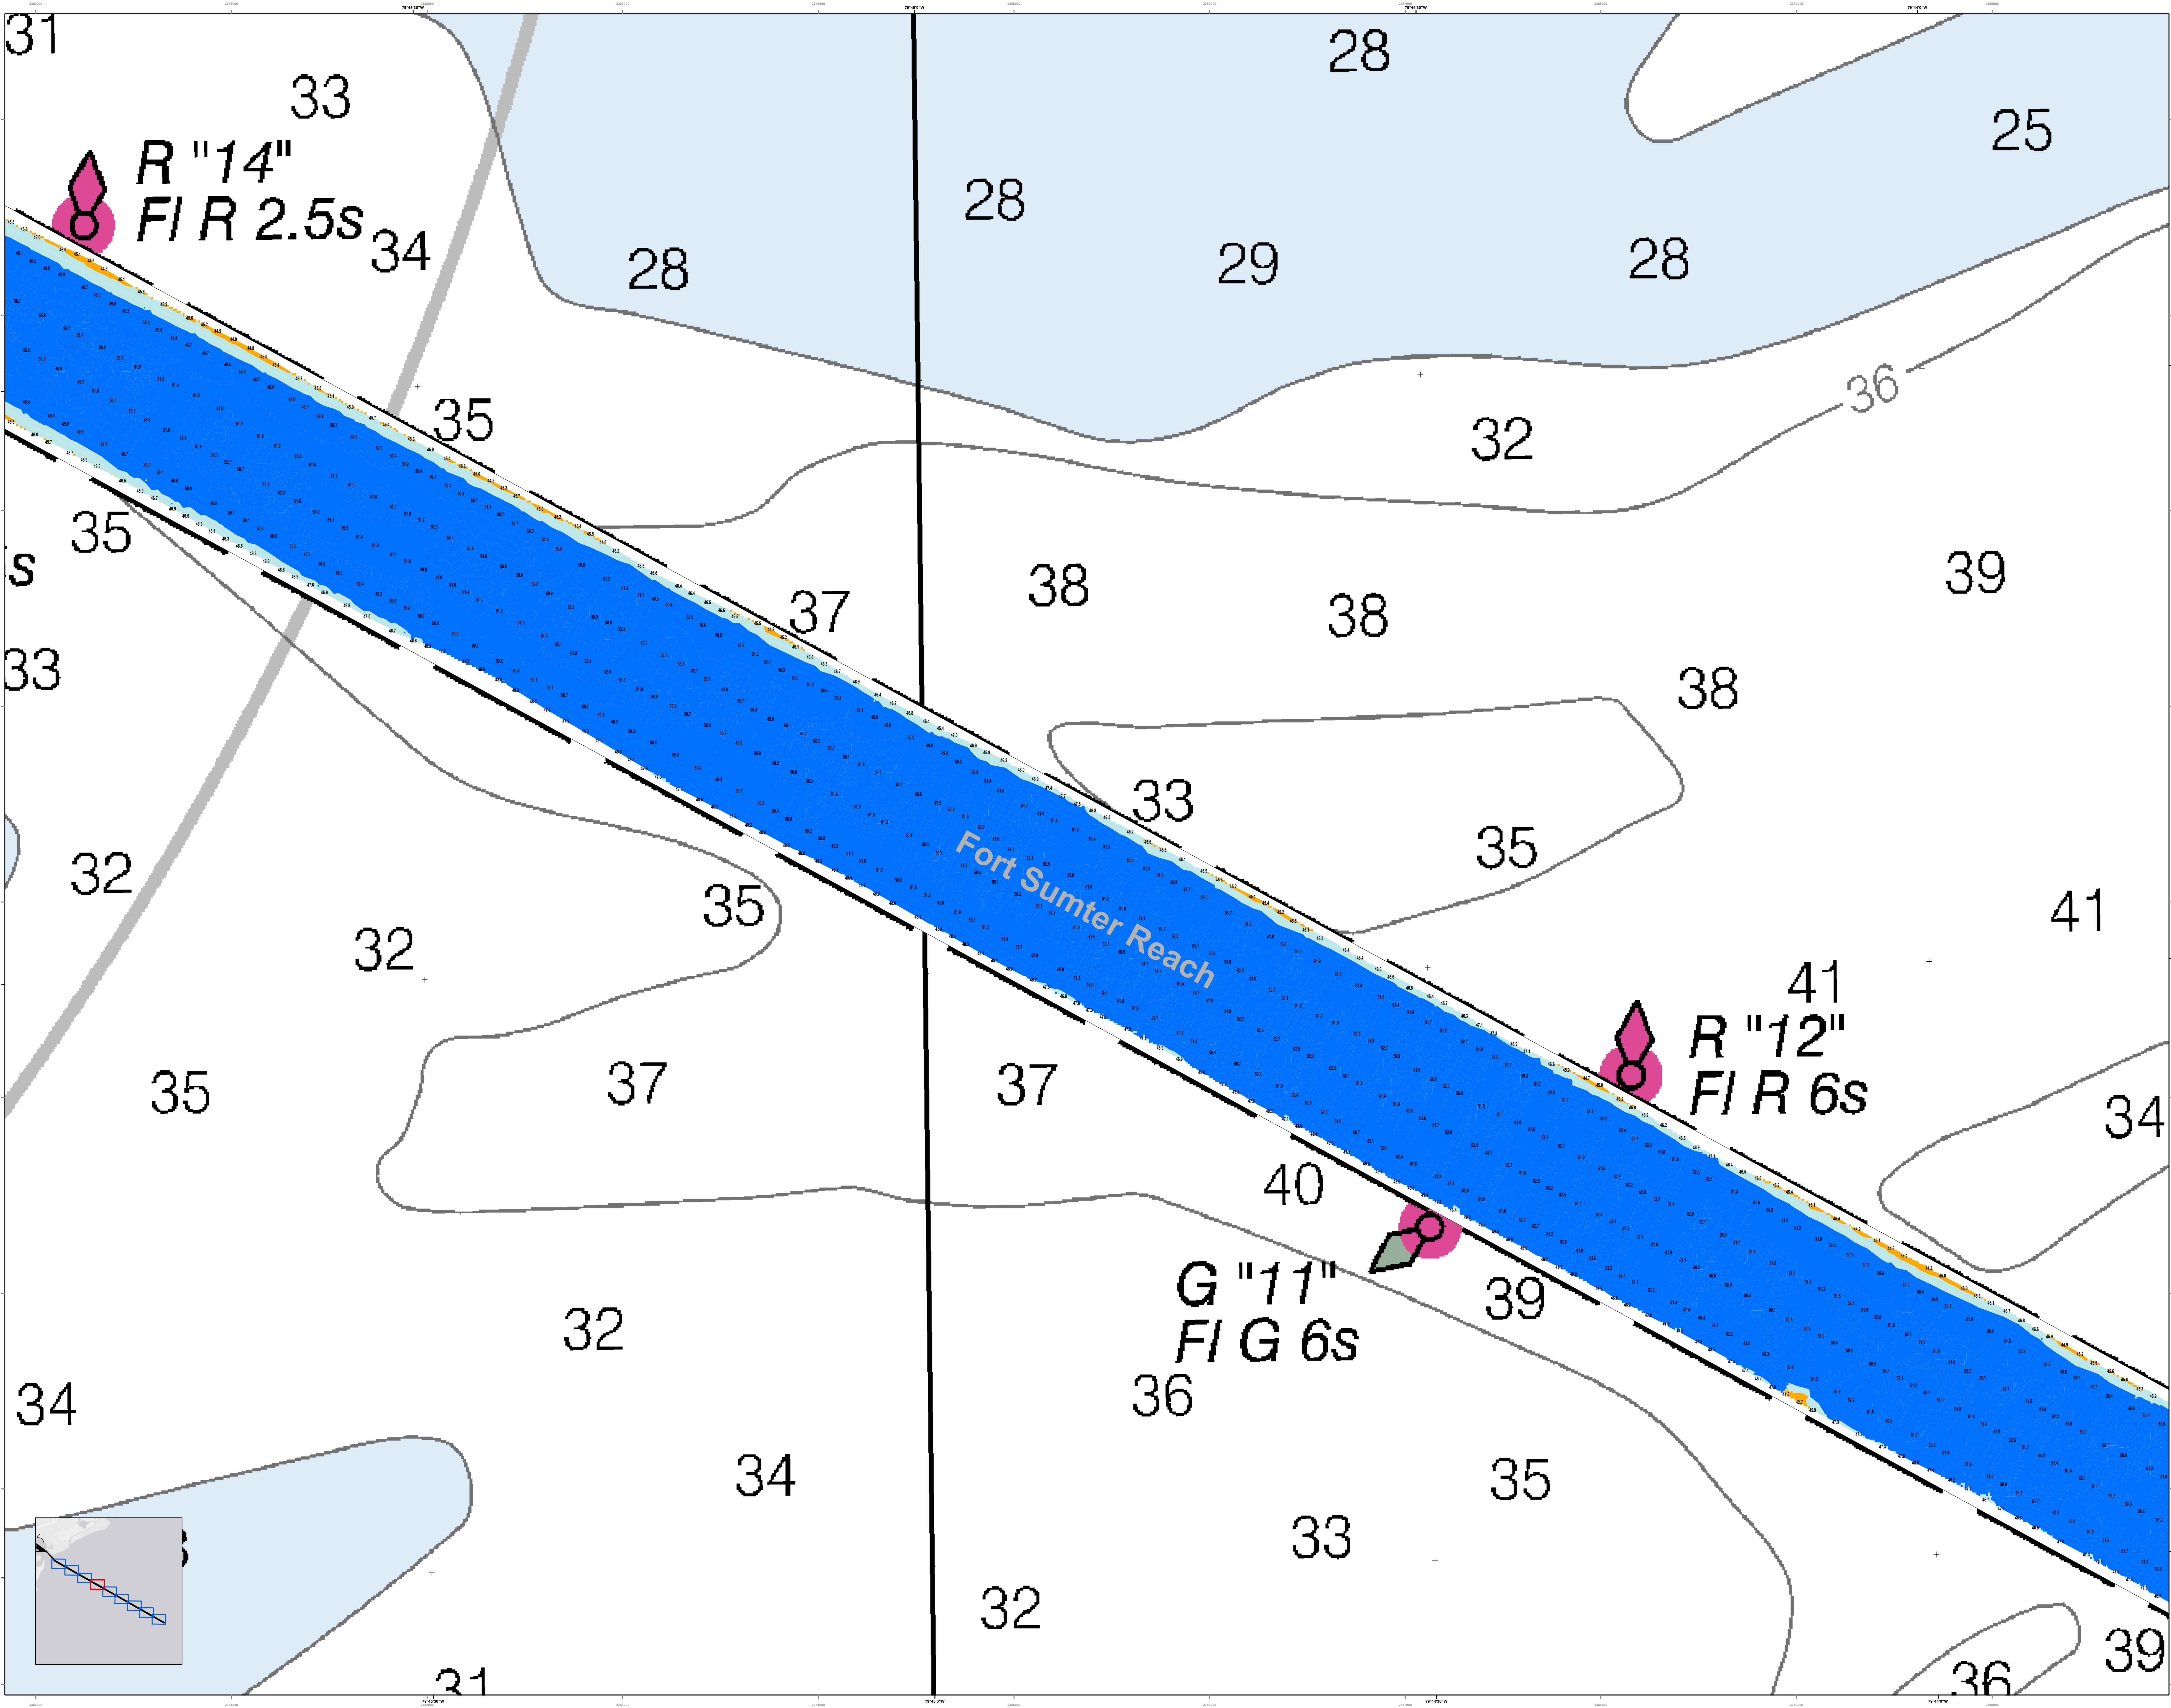




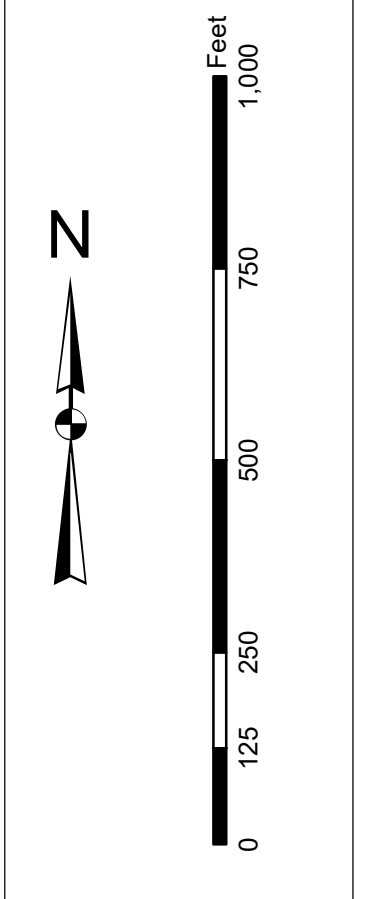

Legend





Designed By:	Hydro Software v3.82	Survey Date:	19 DEC 2017	Production Date:	27 DEC 2017
Reviewed By:	1:50,000	Project Reference Number:	PC00010	Project Reference Number:	PC00010
Revised By:	1 inch = 250 feet	Scale:	CONDITION	Scale:	CONDITION
U.S. Army Corps of Engineers Charleston District Office Special Data Branch 804 MacLeod Ave Charleston, SC 29403		Projection:	NAD 1983 StatePlane South Carolina FIPS 3900 Feet Intl		

Charleston Entrance Channel Survey

Concluded on: 19 DEC 2017
Charleston, South Carolina

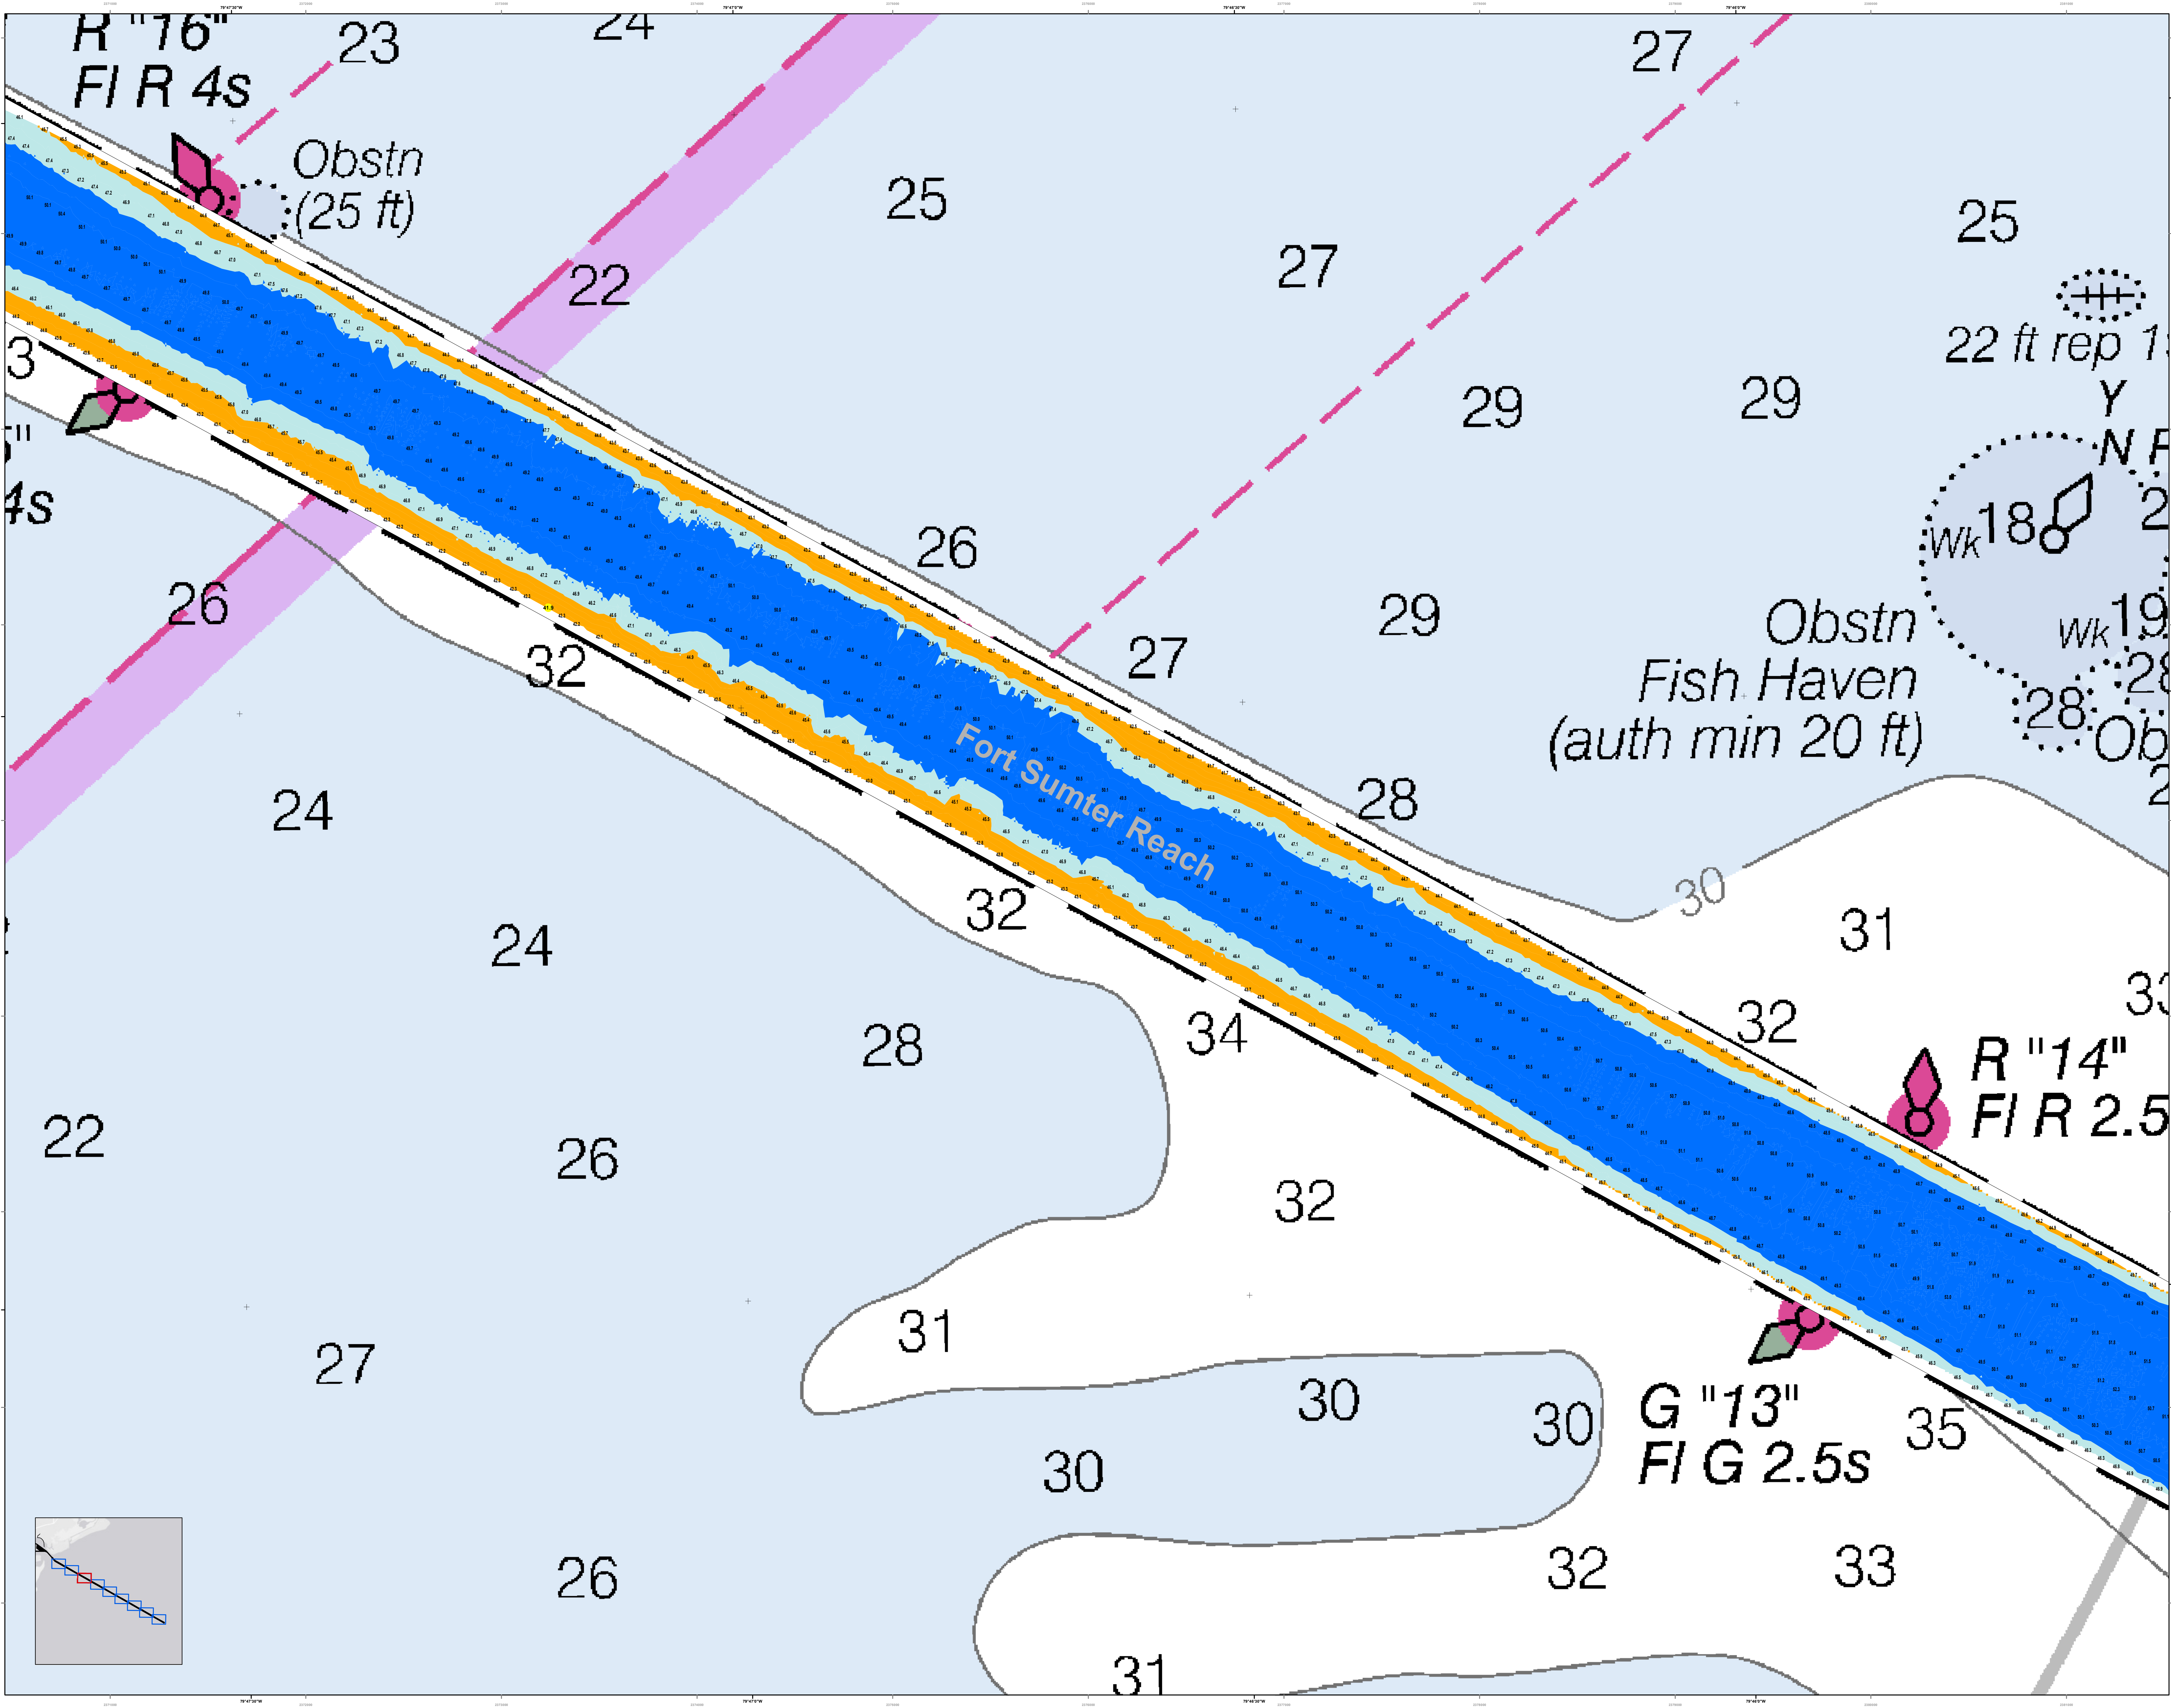

U.S. Army Corps of Engineers
Charleston District


Legend:

Scale:
 0 125 250 500 750 1000 Feet


Designed By:	U.S. Army Corps of Engineers	Survey Date:	19 DEC 2017	Production Date:	27 DEC 2017
Reviewed By:	Charleston District	Project Reference Number:	PC00010	Project Reference Number:	PC00010

Charleston Entrance Channel Survey
 The information depicted on this map represents the results of surveys made on the dates indicated and is not to be used for navigation under general conditions existing at that time.
 Concluded on: 19 DEC 2017
 Charleston, South Carolina

SHEET REFERENCE NUMBER
 C002
 SHEET 7 OF 9





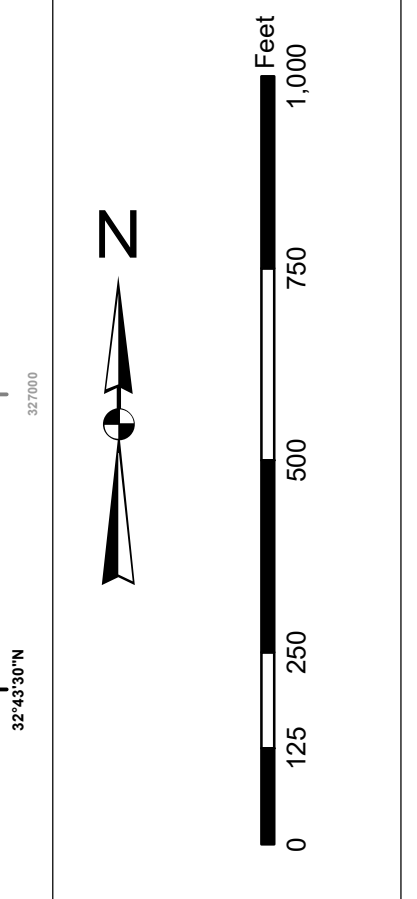




Designed By:	Survey Date:	Production Date:
Reviewed By:	19 DEC 2017	27 DEC 2017
Revised By:	Project Reference Number:	
1:10,000	SC-2017-00010	
1 inch = 250 feet	Survey Scale:	CONDITION
Projection:	NAD 1983 StatePlane South Carolina FIPS 3800 Feet Int	

Charleston Entrance Channel Survey
 The information depicted on this map represents the results of surveys made on the dates indicated and call on the surveys on which they are based. The general conditions existing at that time are shown. This map was compiled on: 19 DEC 2017
 Charleston, South Carolina

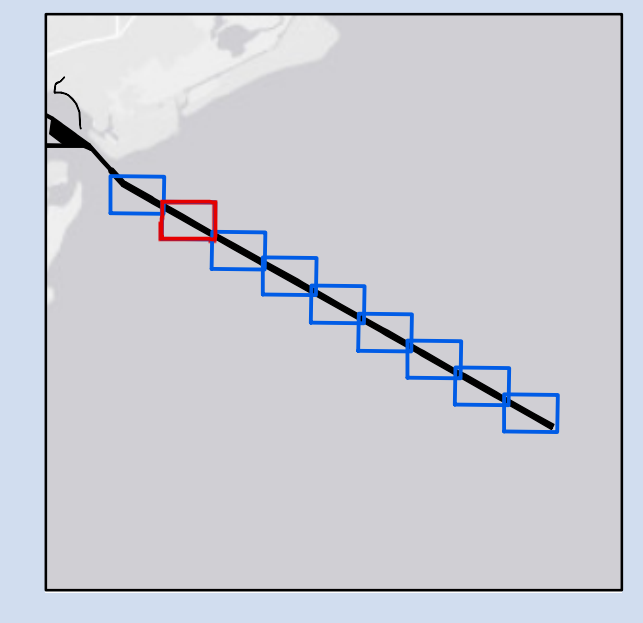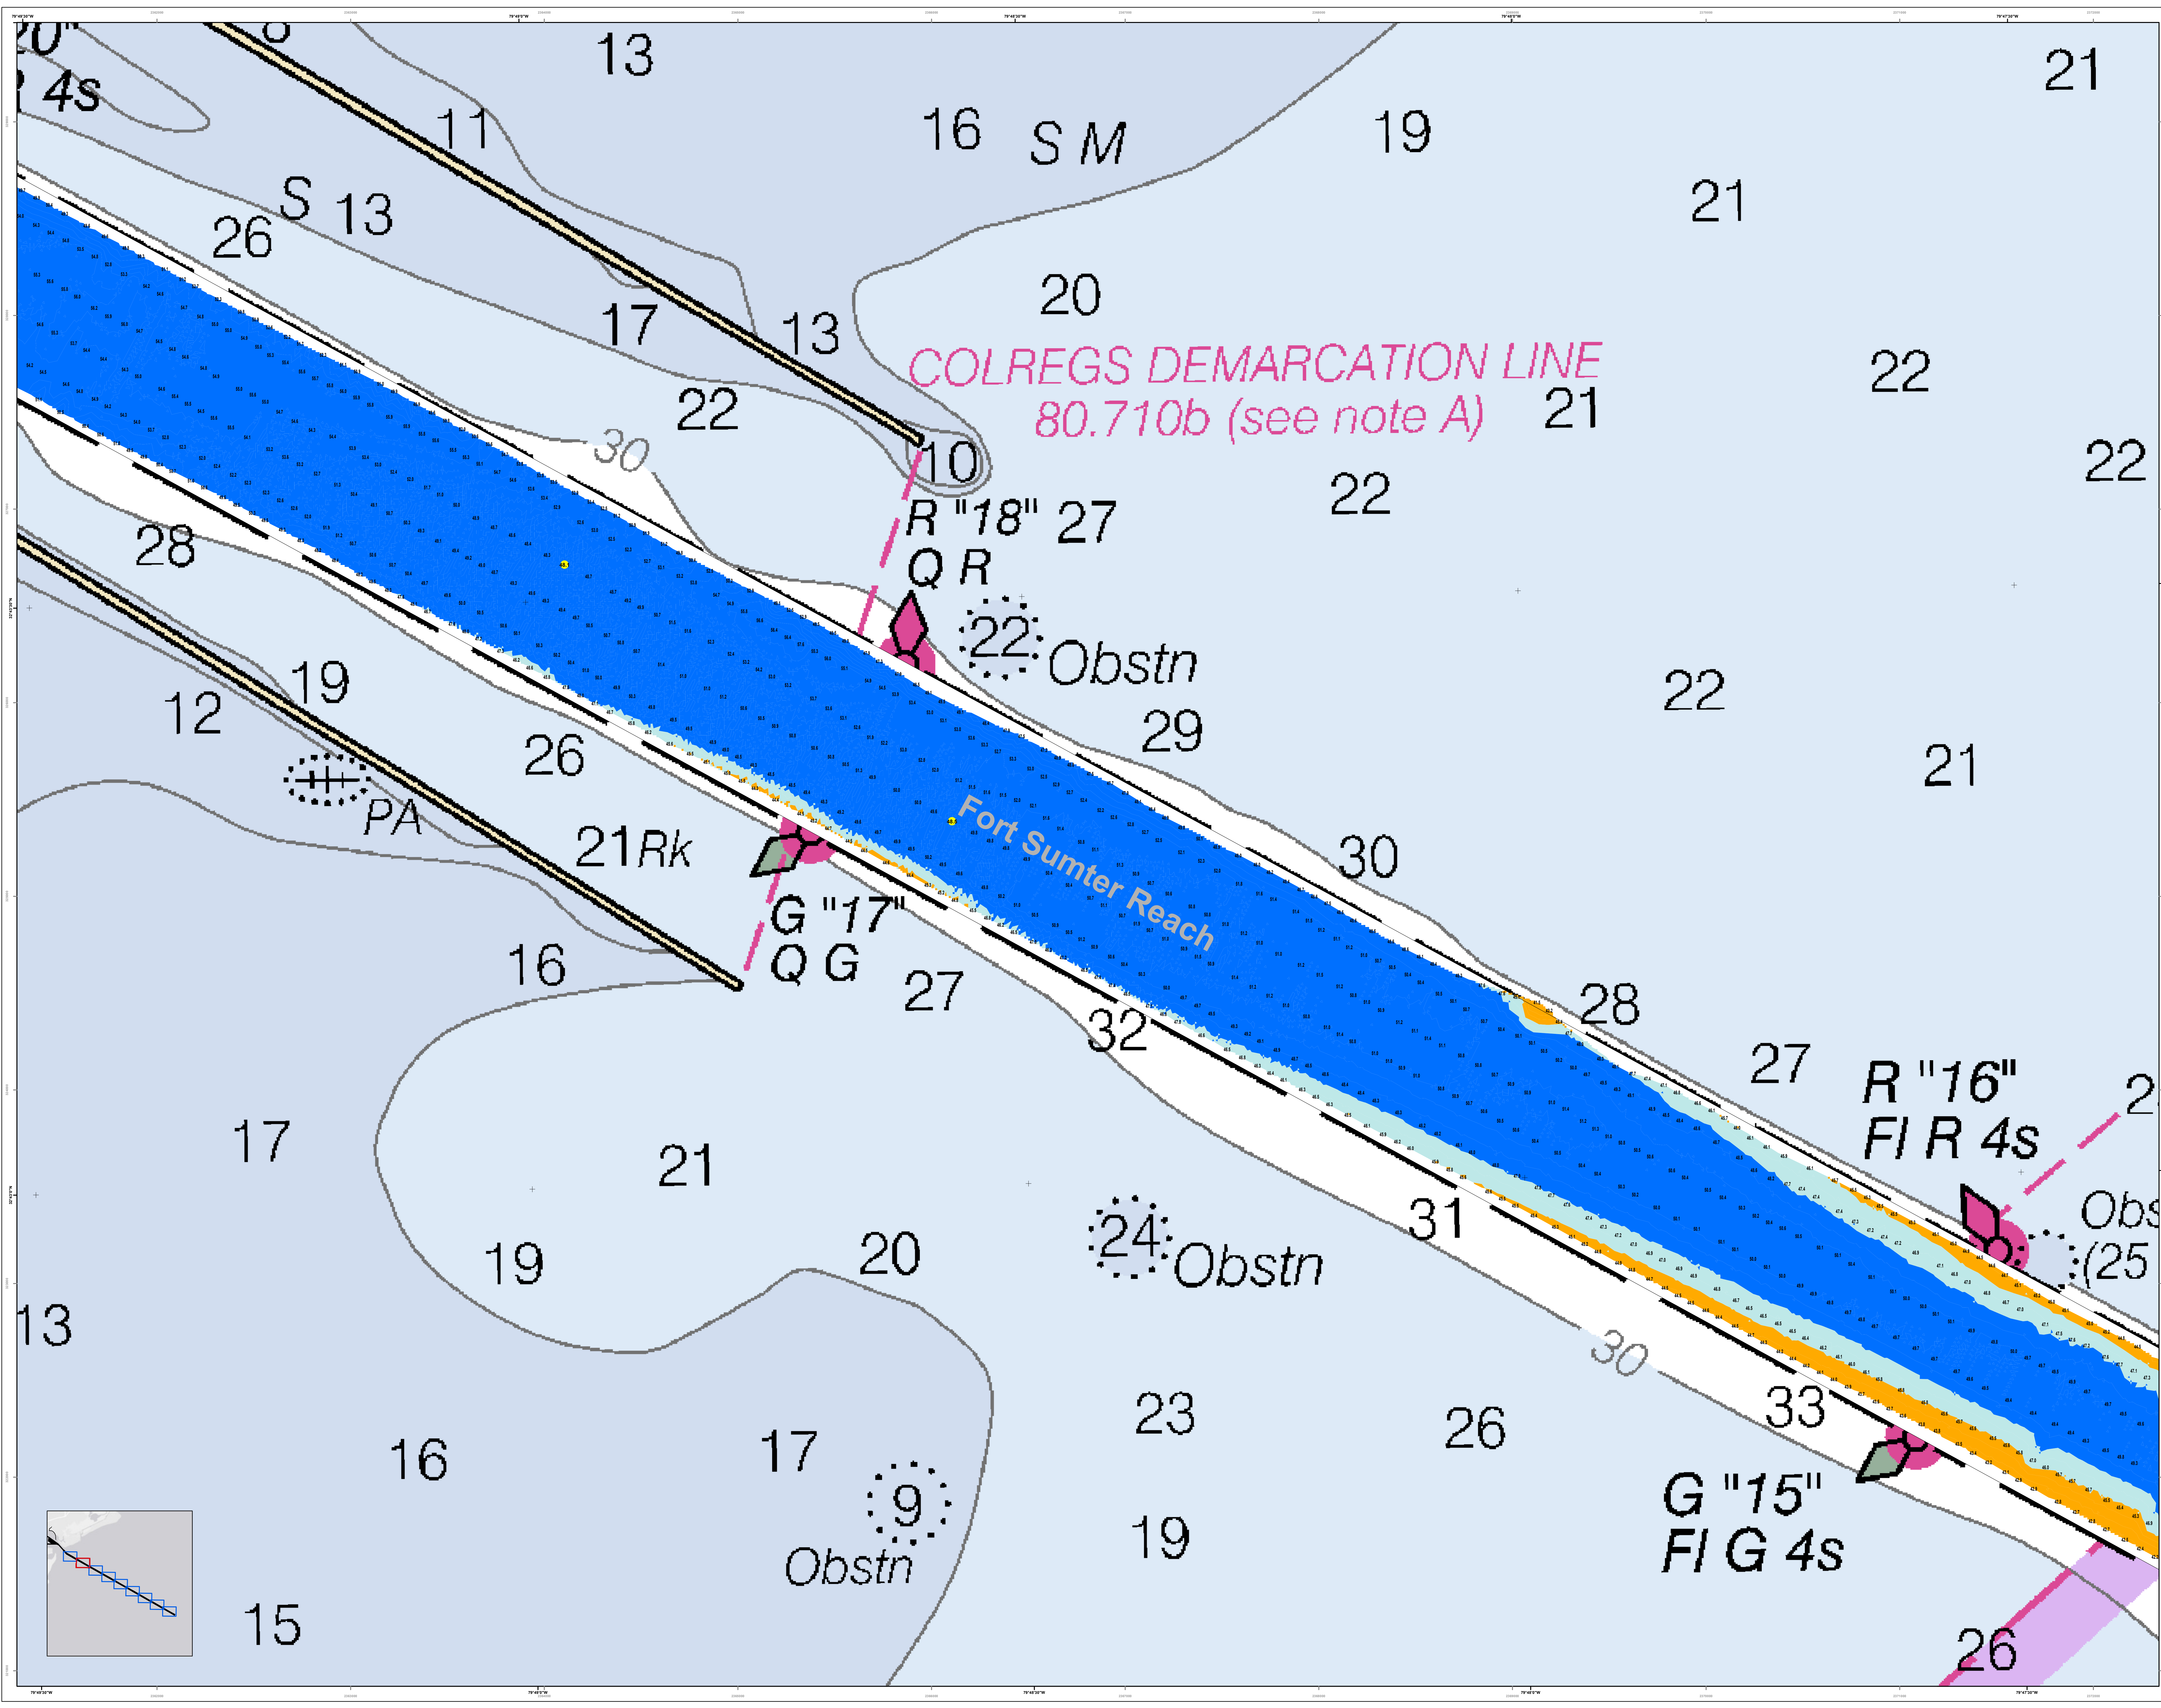




Charleston Entrance Channel Survey
The information depicted on this map represents the results of surveys made on the dates indicated and is not to be used for navigation. The information on this map is based on the most recent available data.
Concluded on: 19 DEC 2017
Charleston, South Carolina

