



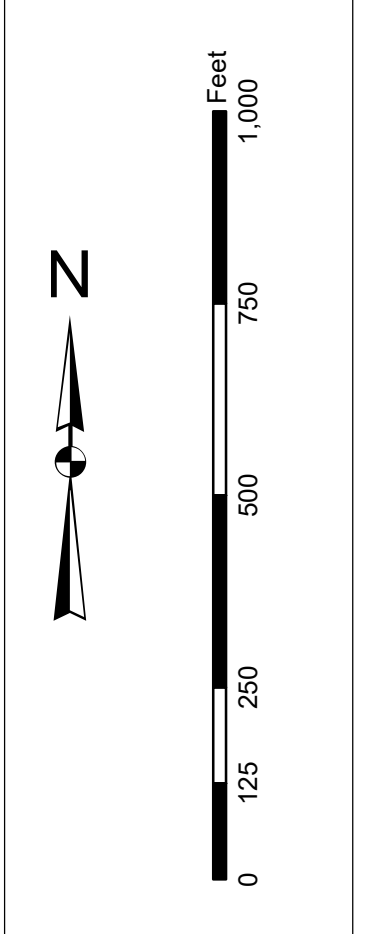




U.S. Army Corps of Engineers Charleston District Office Charleston, South Carolina	Survey Date: 19 FEB 2019	Production Date: 22 Feb 2019
Project Reference Number: 13000	Scale: 1 inch = 250 feet	Projection: NAD 1983 StatePlane South Carolina FIPS 3200 Feet
Survey Type: CONDITION	Author: CESAC/GIS/USACE/ARMY/MIL	

**Charleston Upper Harbor Channel Survey**  
 The information depicted on this map represents the results of surveys made on the dates indicated and can only be used for the purposes for which it was prepared. It is not to be used for any other purpose without the express approval of the U.S. Army Corps of Engineers, Charleston District Office.  
 Concluded on: 19 FEB 2019  
 Charleston, South Carolina

In accordance with the U.S. Army Corps of Engineers, Charleston District Office, Special Data Branch, the information on this map represents the results of surveys made on the dates indicated and conditions existing at that time. It is not intended to be used for navigation. No warranty is made by the Corps of Engineers for any use of this information other than that for which it was prepared. The Corps of Engineers is not responsible for any errors or omissions in this information.

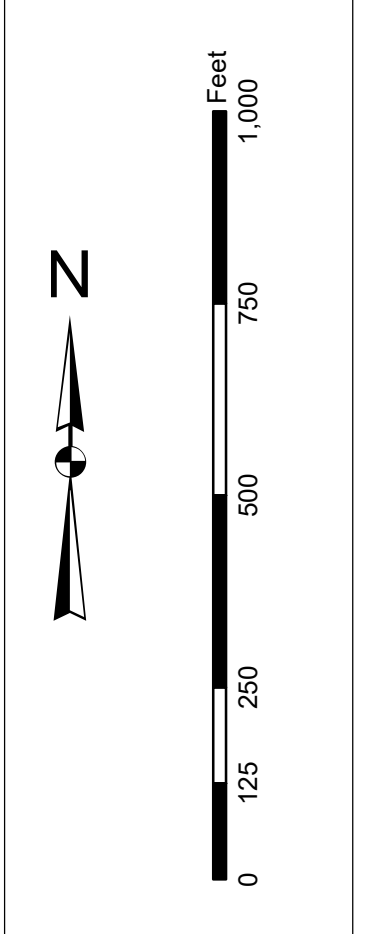




Projection: NAD 83 StatePlane South Carolina FIPS 3200 Feet	

Charleston, South Carolina

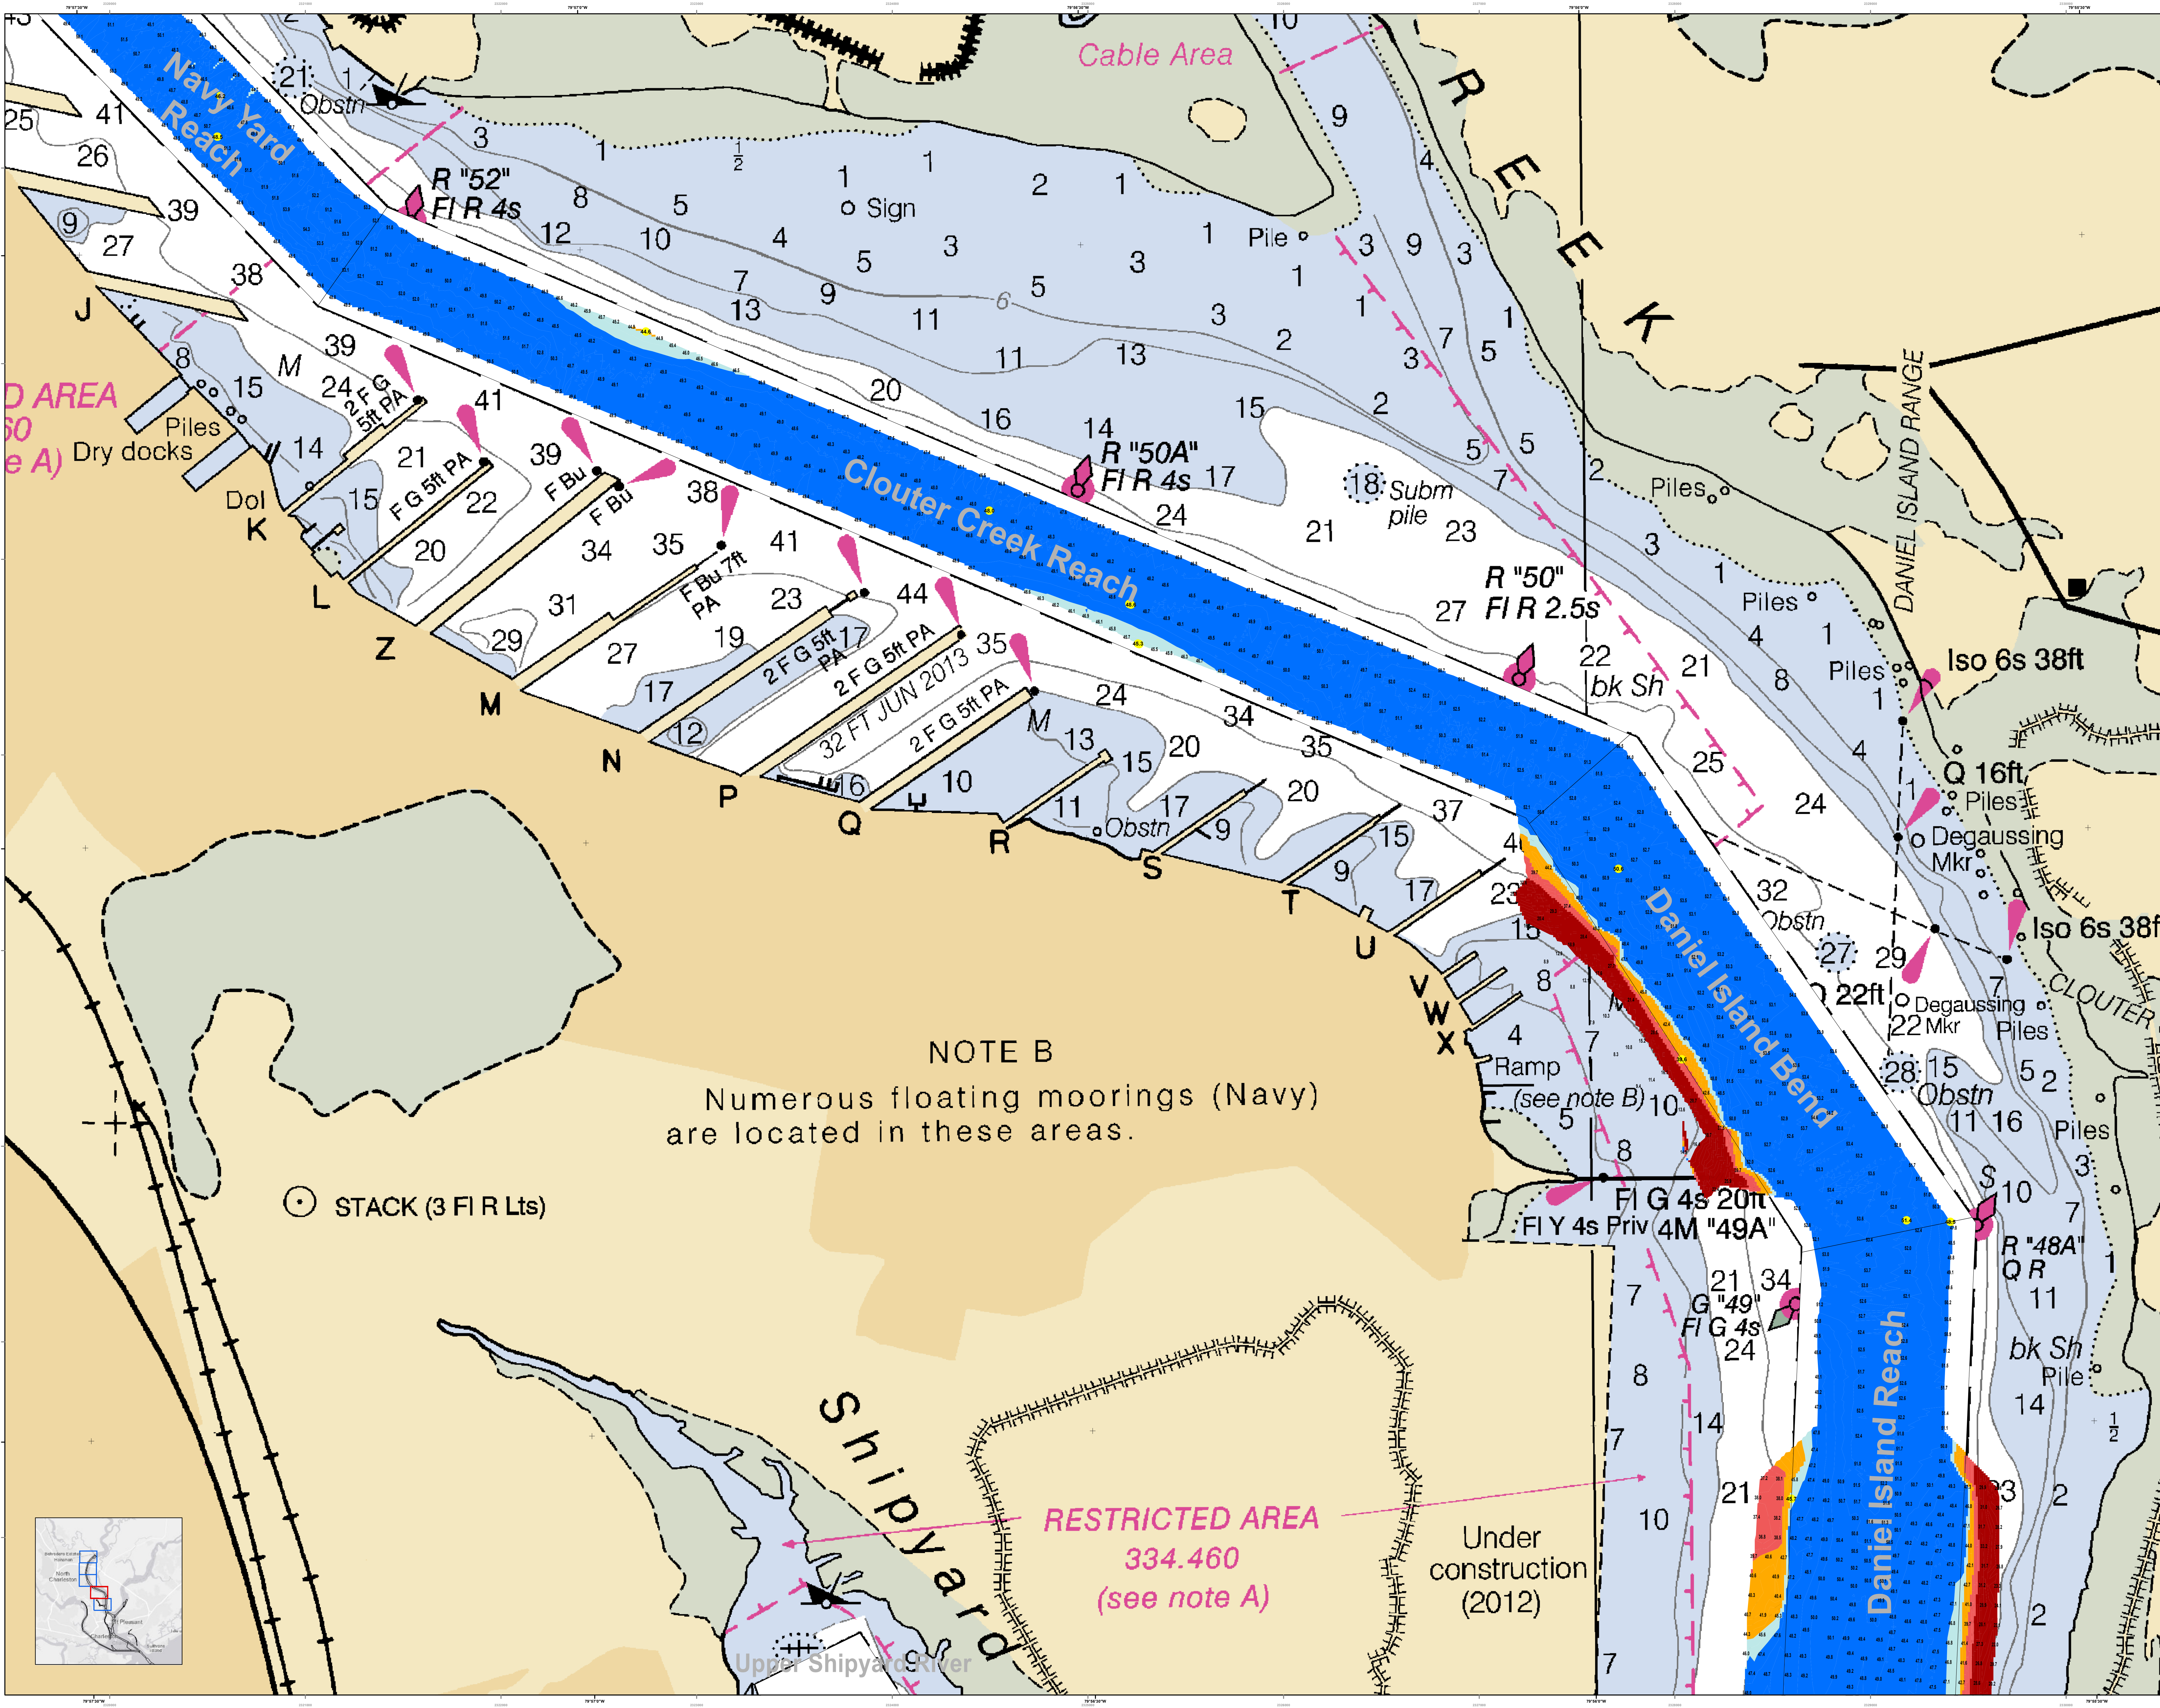


**NOTE B**  
Numerous floating moorings (Navy) are located in these areas.

⊙ STACK (3 FI R Lts)

**RESTRICTED AREA**  
334.460  
(see note A)


Under construction  
(2012)

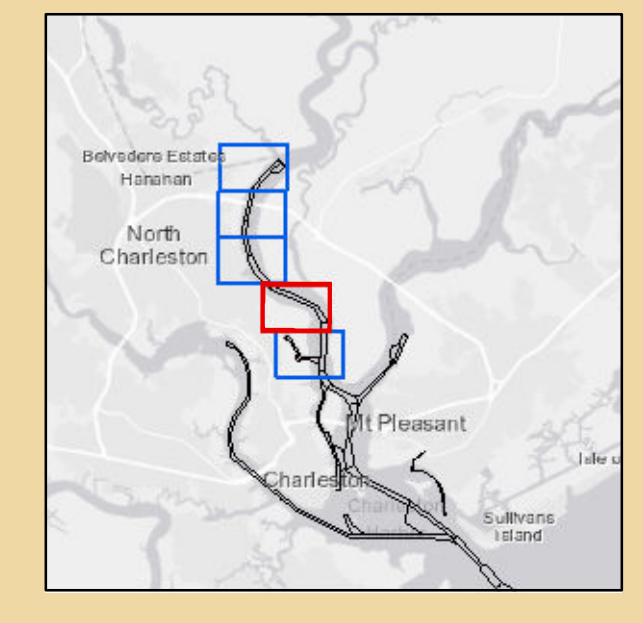







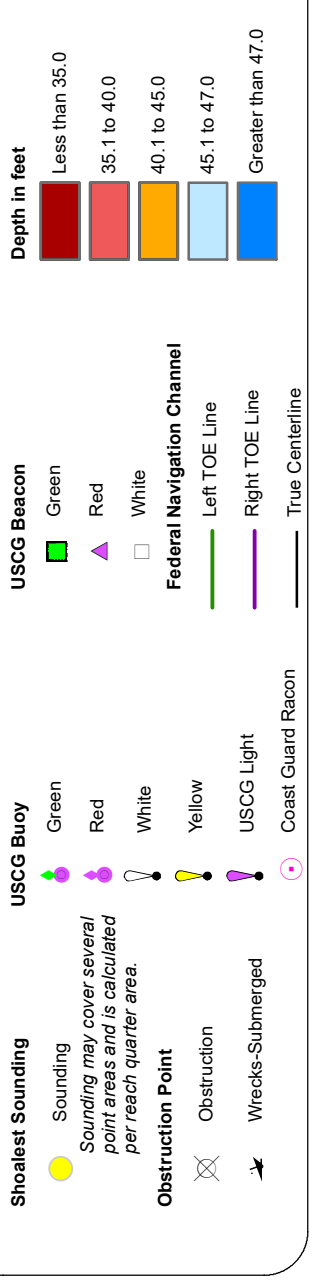



**Charleston Upper Harbor Channel Survey**  
The information shown on this map represents the results of surveys made on the dates indicated and is not to be used for navigation. It is general information only. No warranty is made as to the accuracy of the data. The user is responsible for determining the accuracy of the data for their intended use.  
Concluded on: 19 FEB 2019  
Charleston, South Carolina

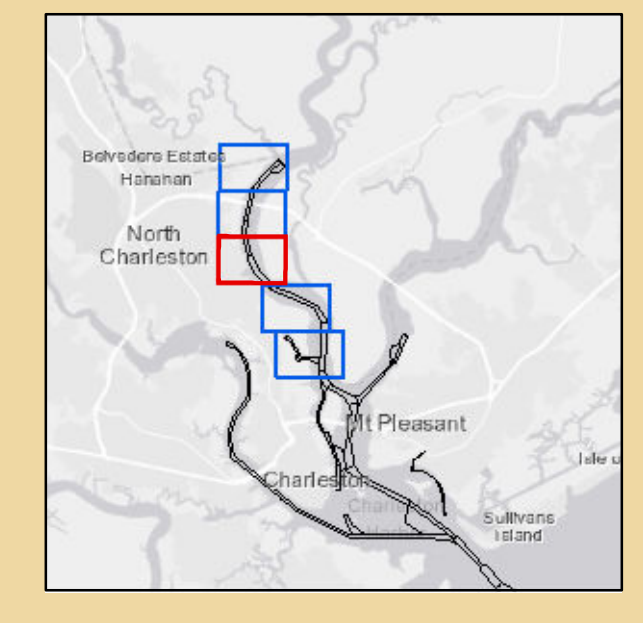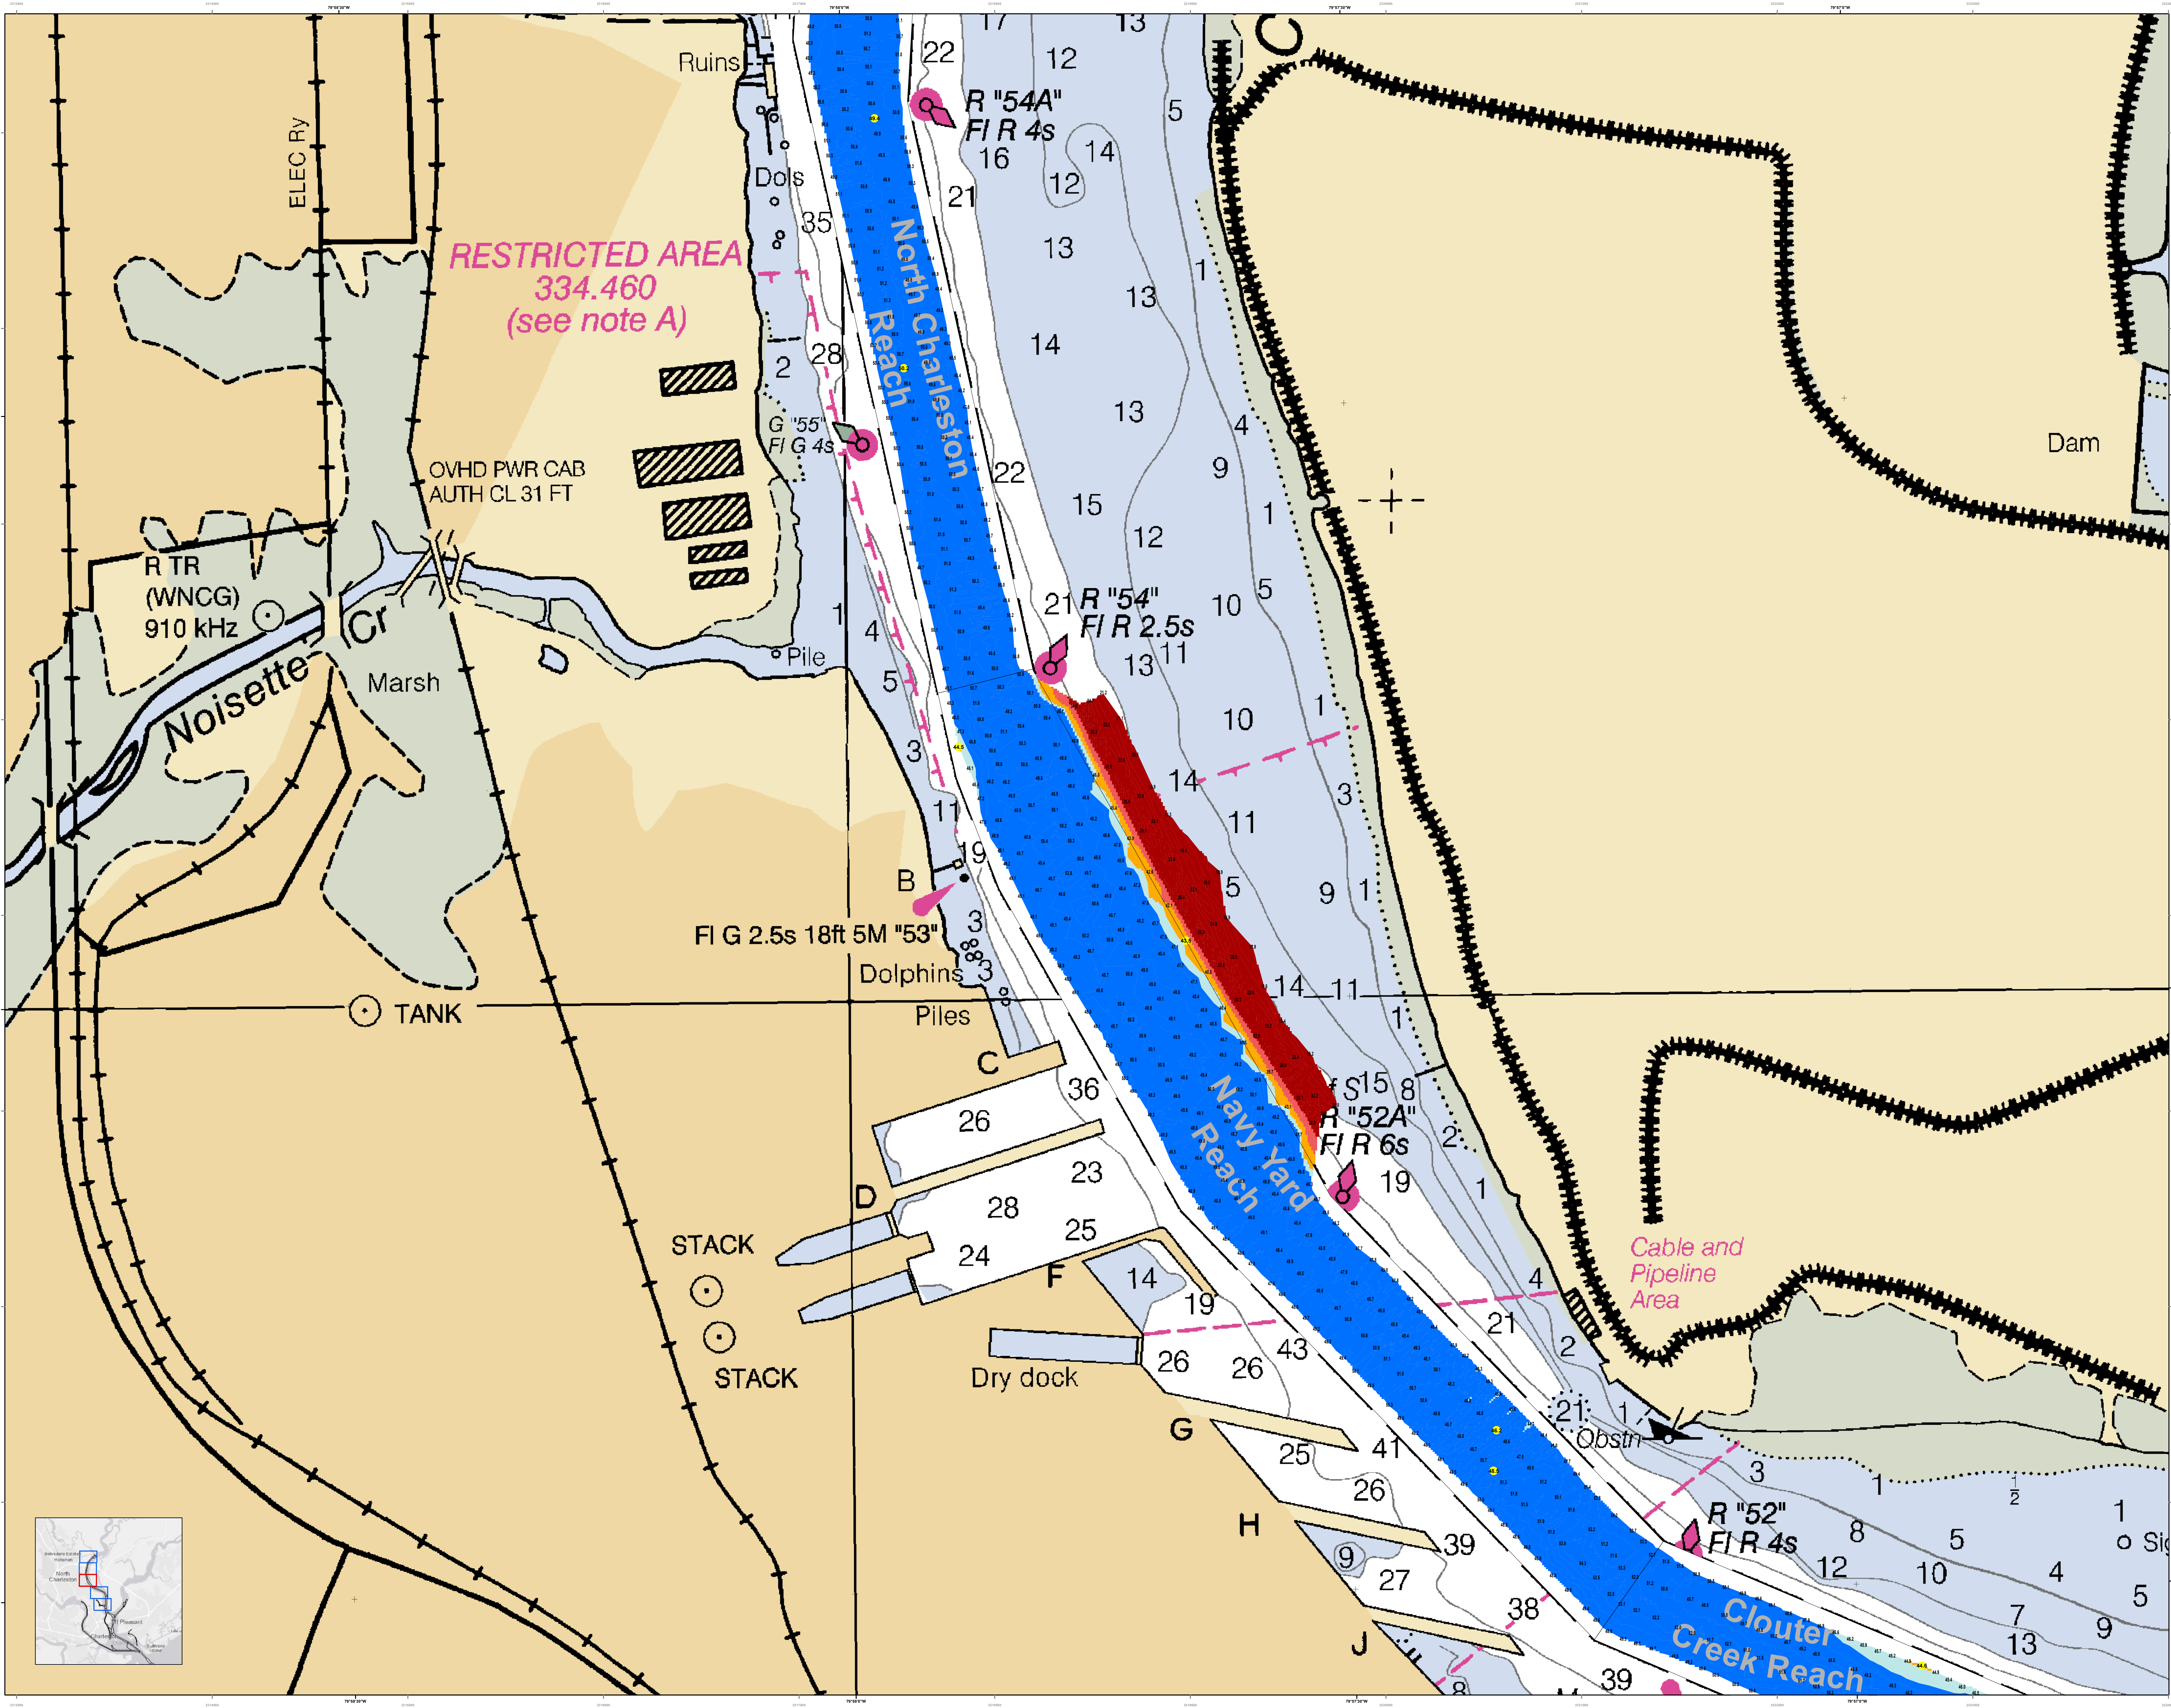


# OVERHEAD CABLE CLEARANCES

- (A) OVHD PWR CABS  
CL 163 FT REP
- (B) OVHD PWR CABS  
CL 182 FT REP
- (C) OVHD PWR CABS  
CL 166 FT REP
- (D) OVHD PWR CABS  
CL 104 FT REP

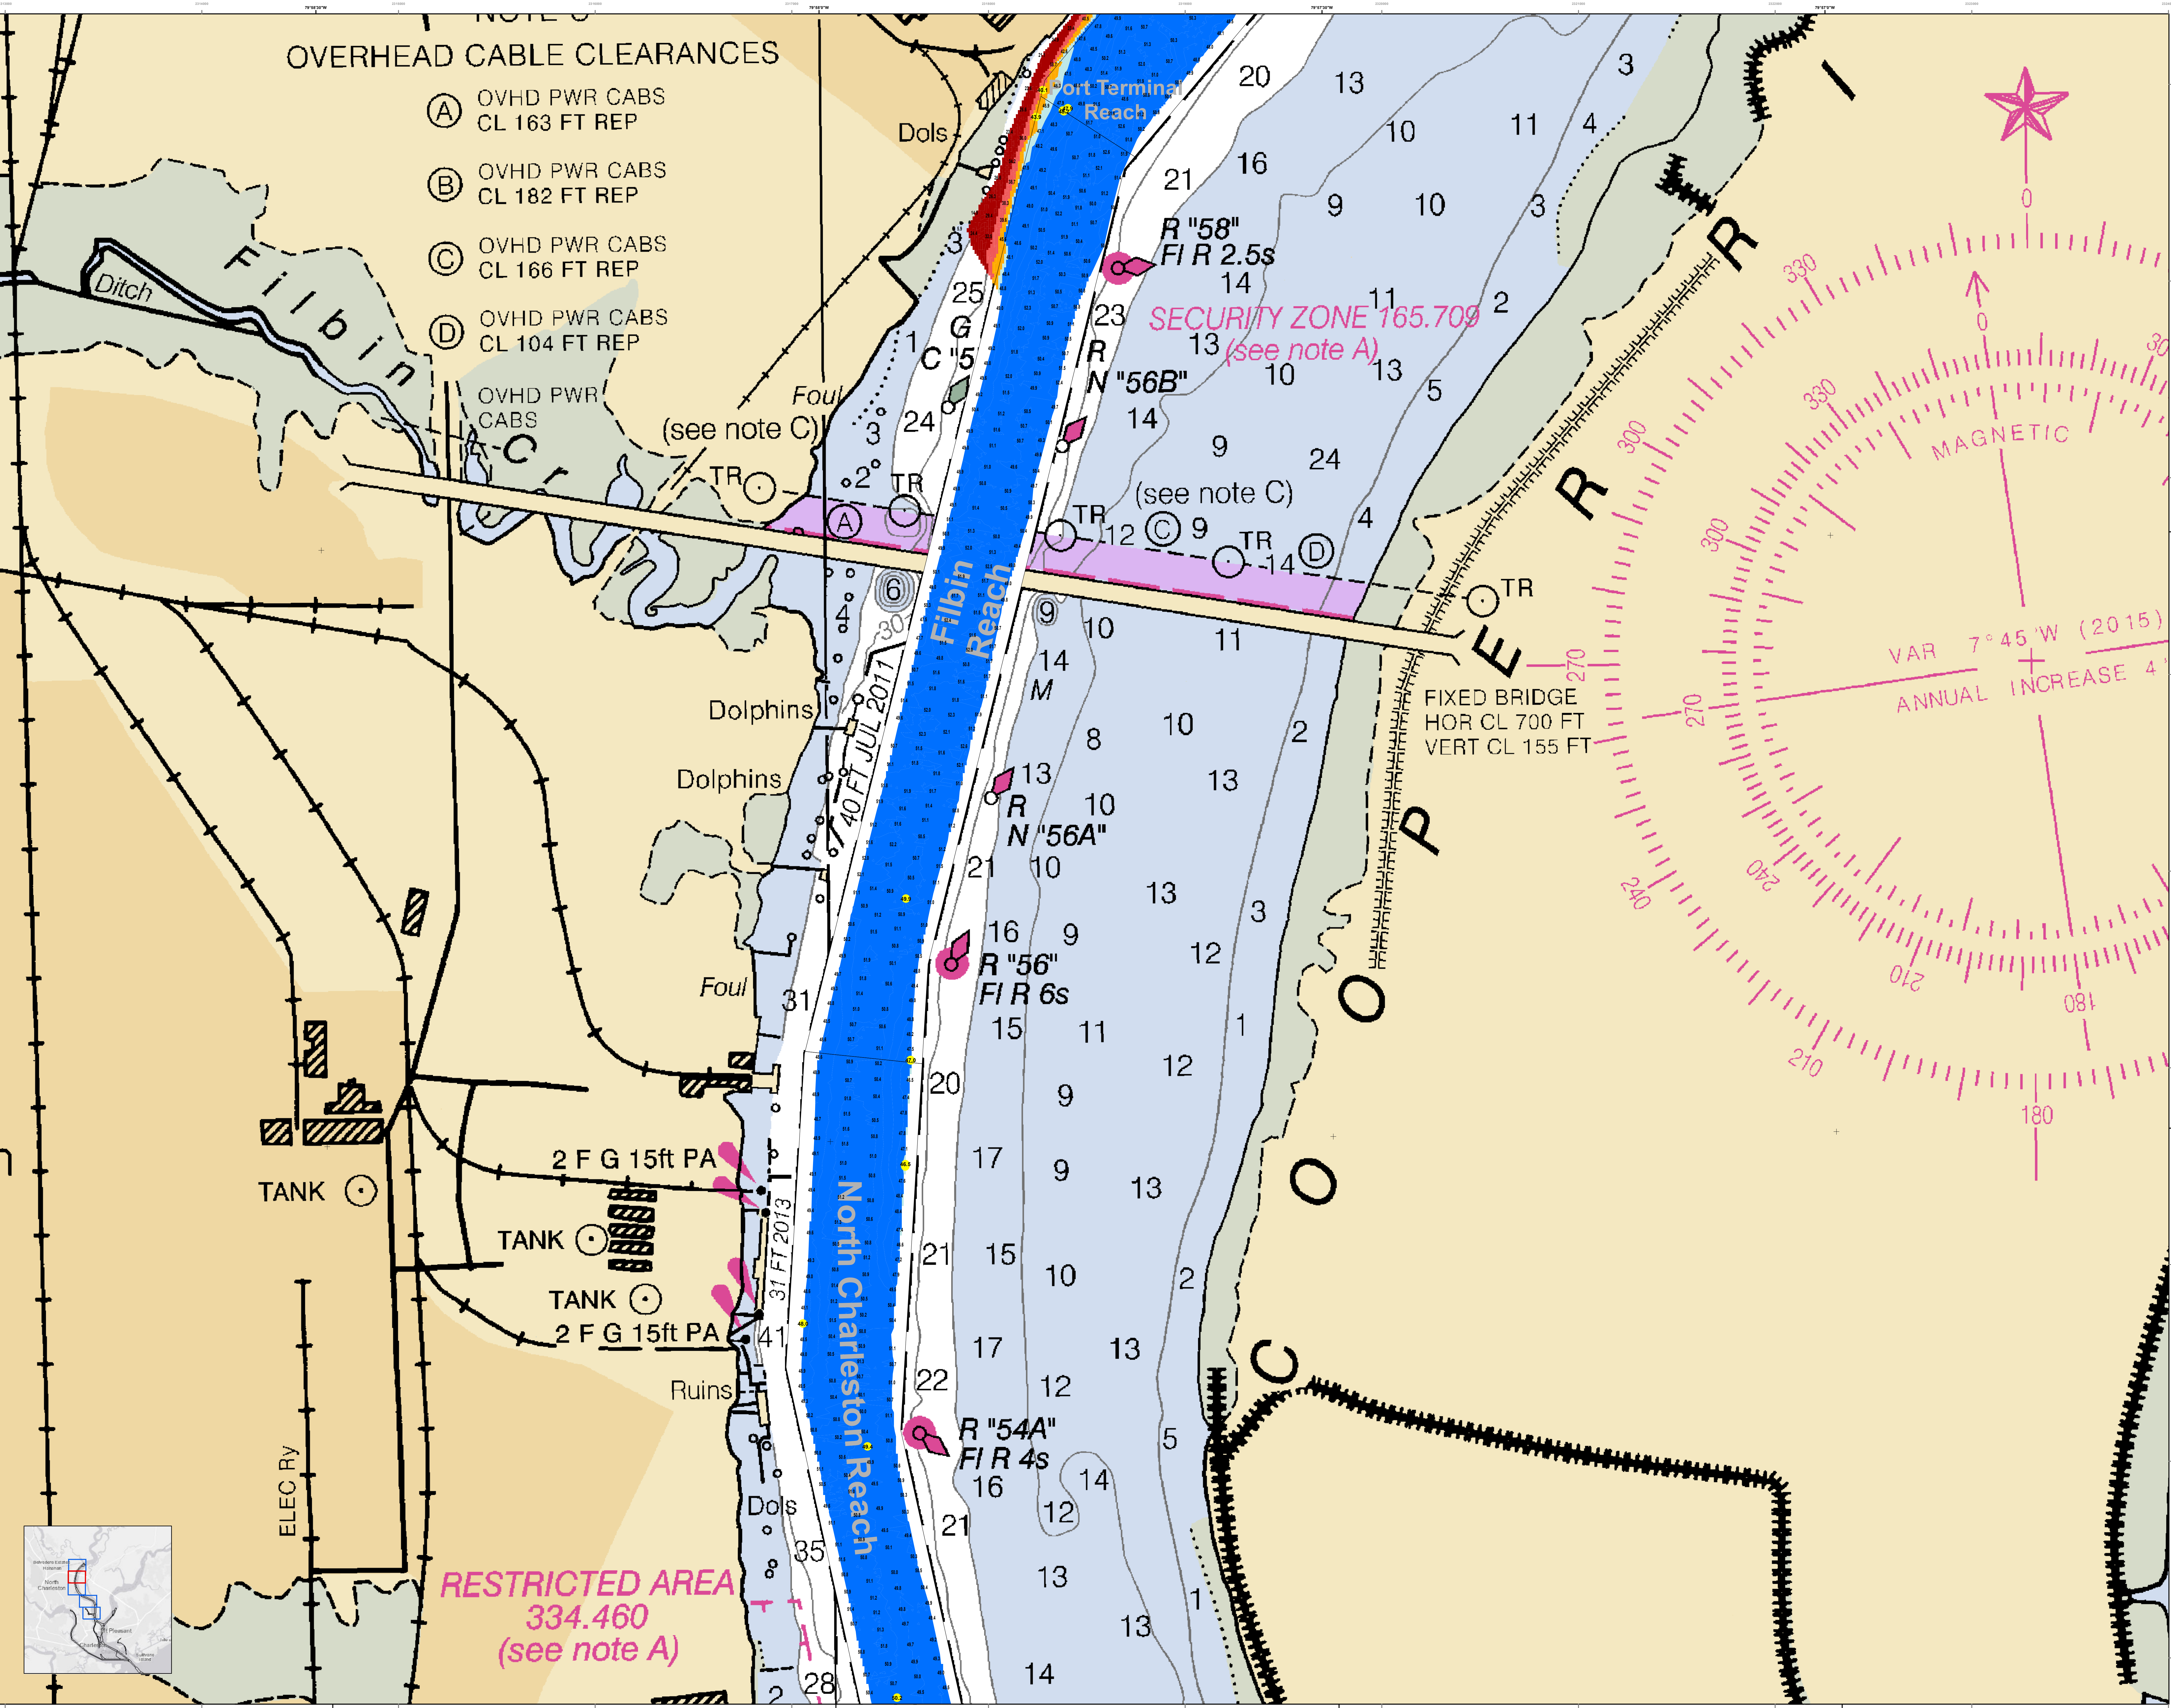

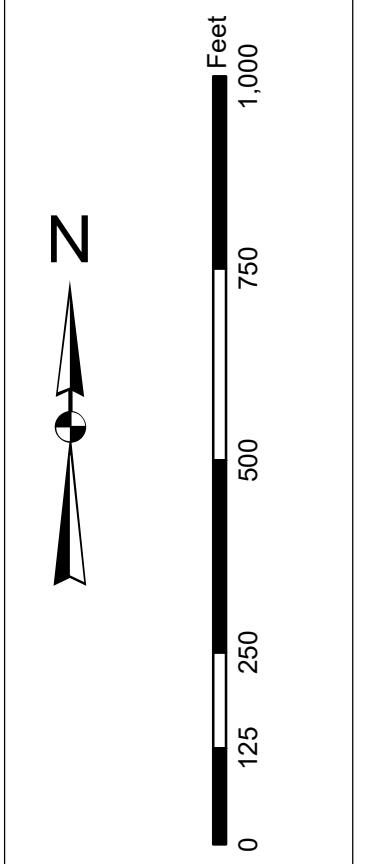







**Charleston Upper Harbor Channel Survey**  
 The information depicted on this map represents the results of surveys made on the dates indicated and conditions existing at that time.  
 Concluded on: 19 FEB 2019  
 Charleston, South Carolina


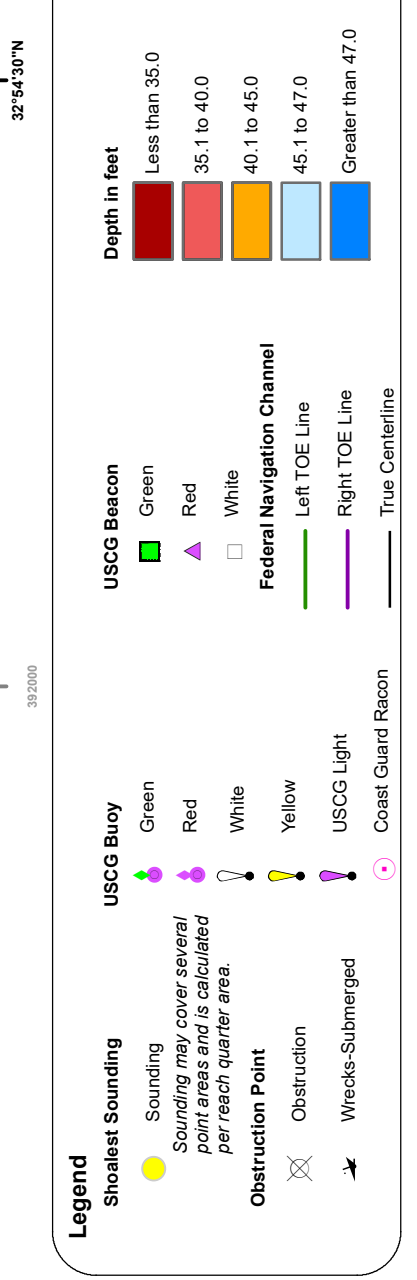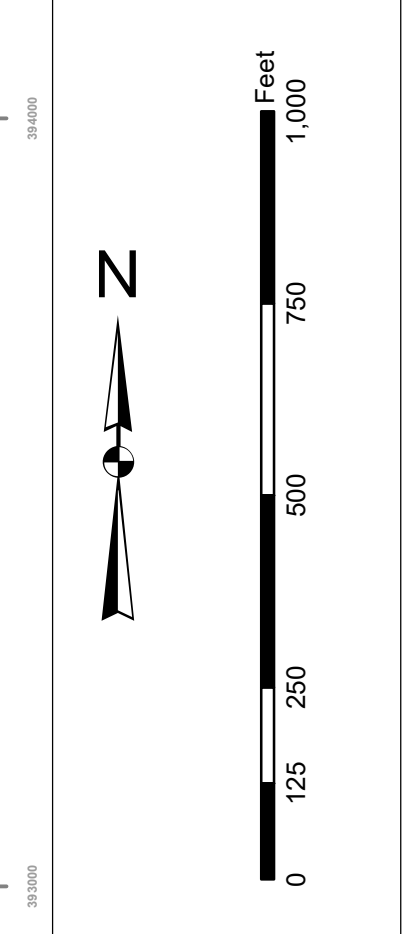


**Charleston Upper Harbor Channel Survey**  
 The information depicted on this map represents the results of surveys made on the dates indicated and conditions existing at that time.  
 Concluded on: 19 FEB 2019  
 Charleston, South Carolina

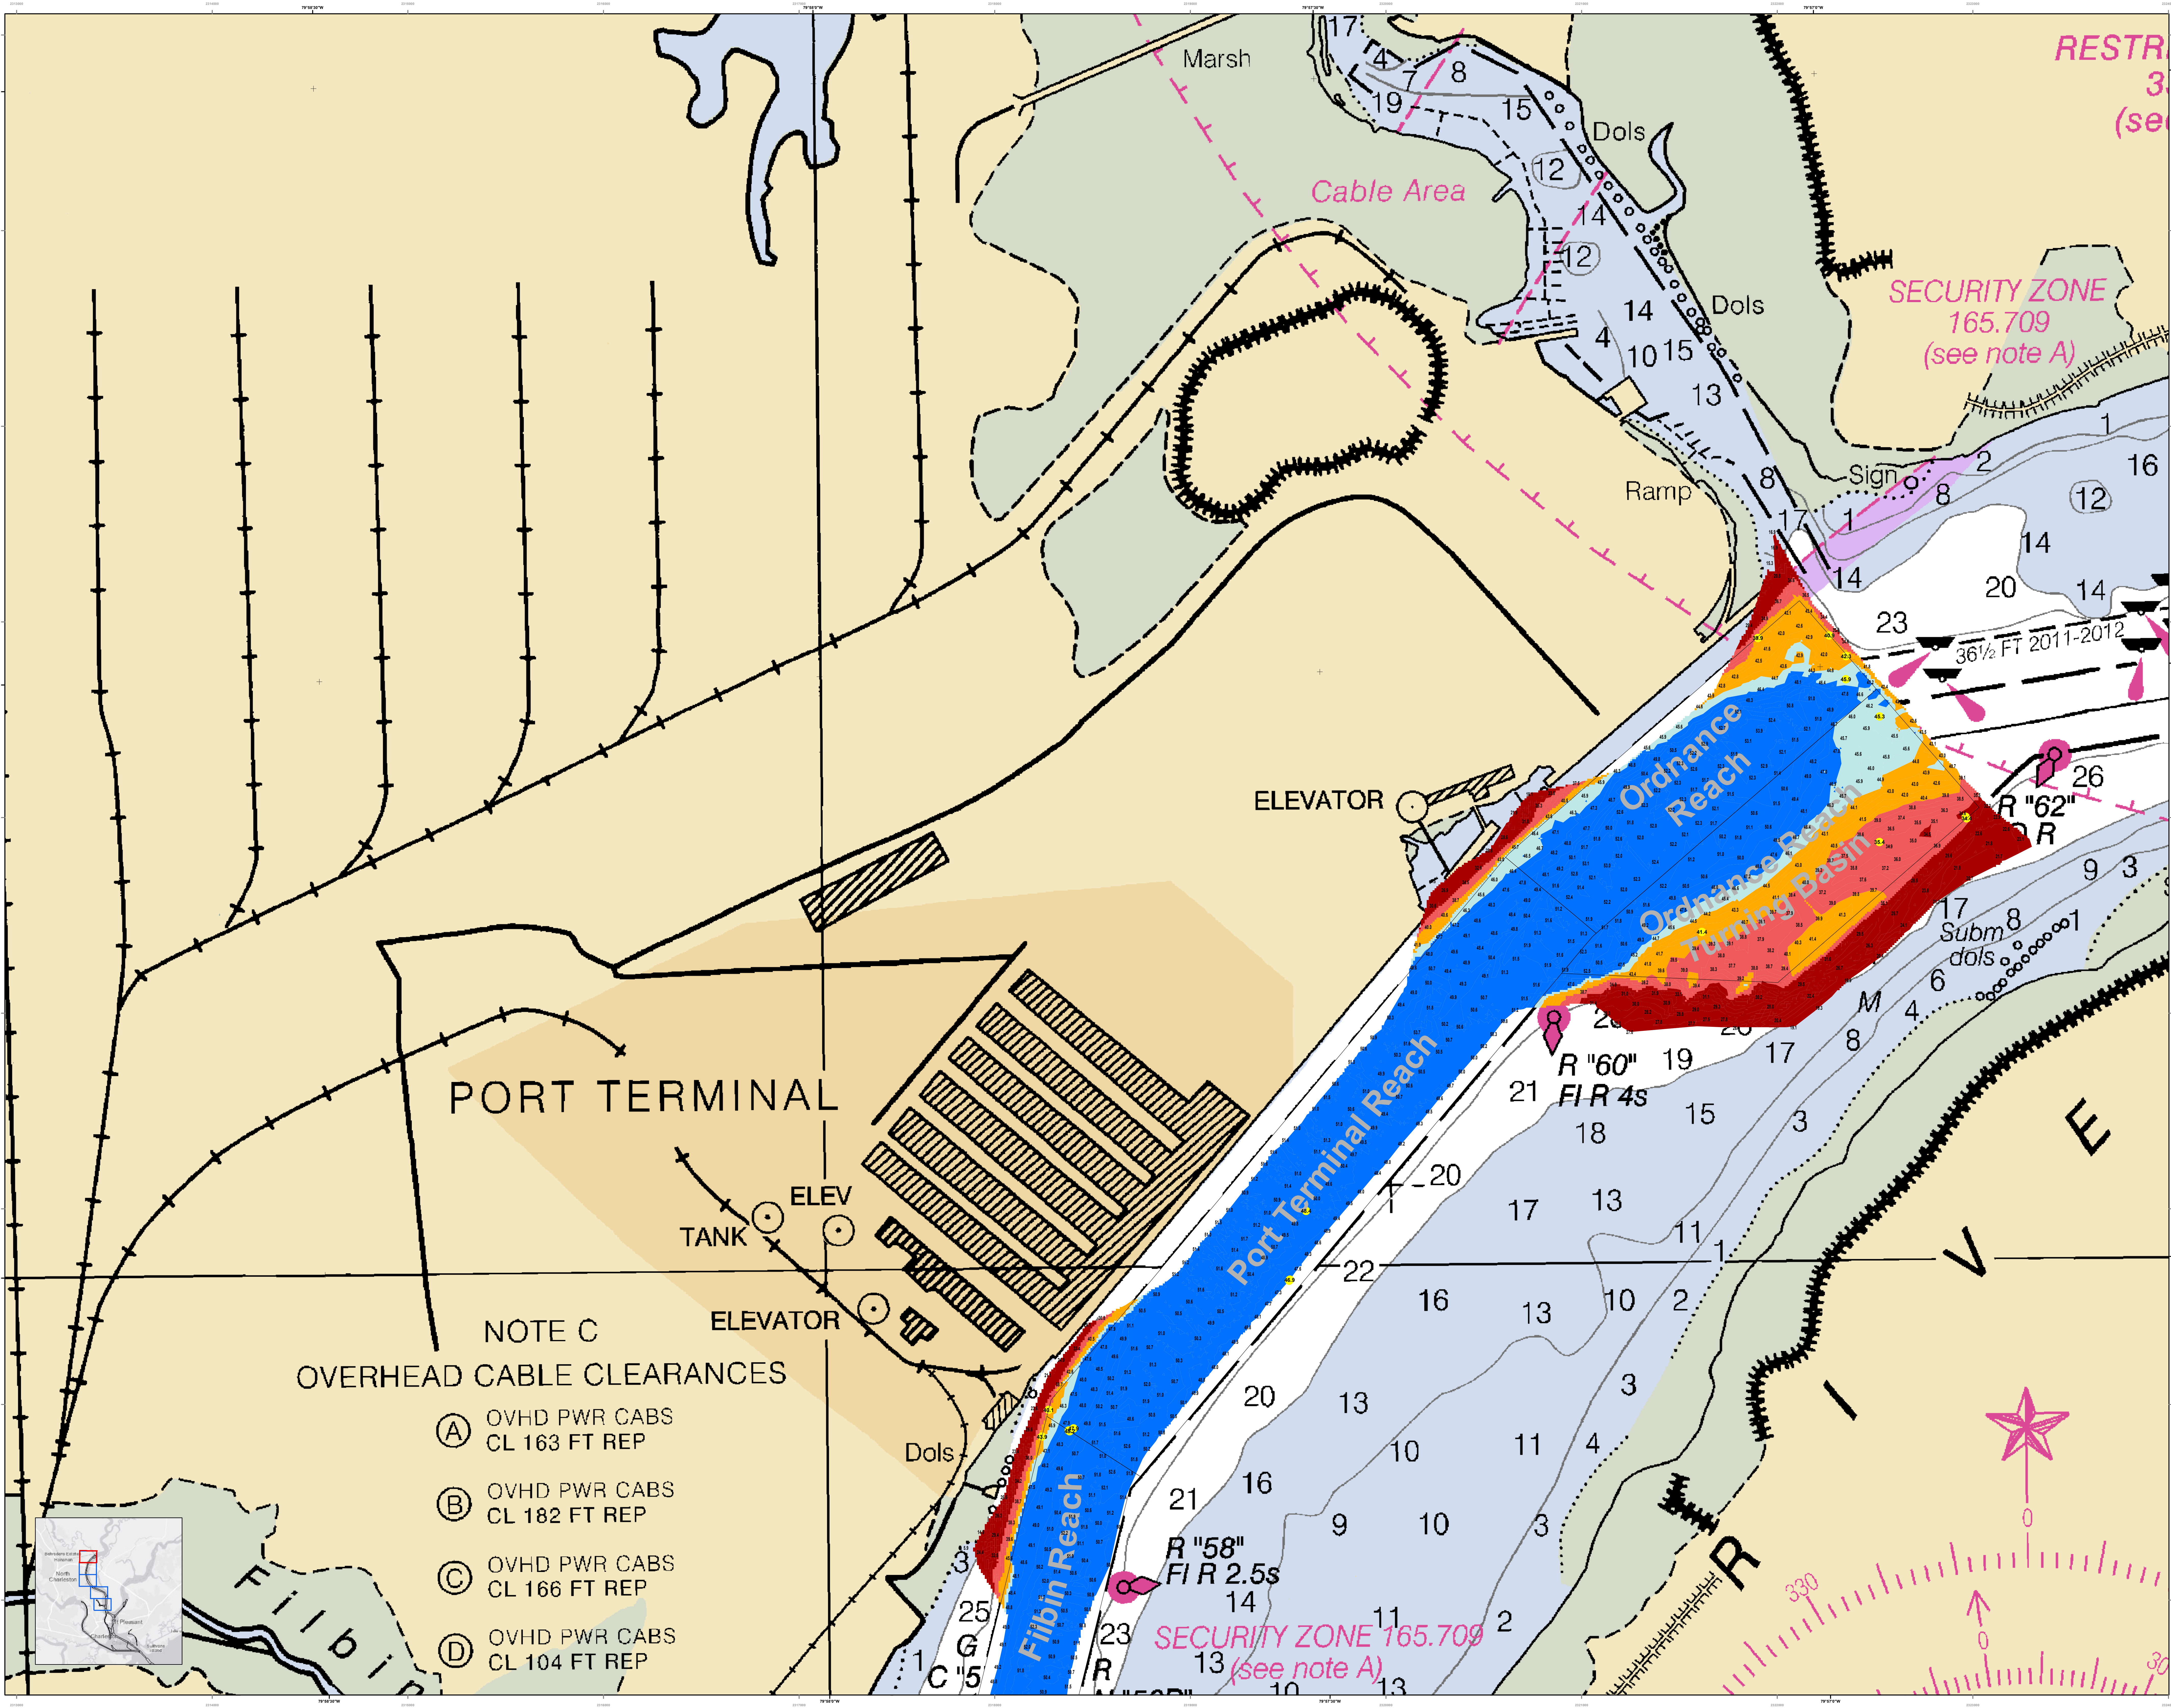

**NOTE C**  
OVERHEAD CABLE CLEARANCES

- (A) OVHD PWR CABS  
CL 163 FT REP
- (B) OVHD PWR CABS  
CL 182 FT REP
- (C) OVHD PWR CABS  
CL 166 FT REP
- (D) OVHD PWR CABS  
CL 104 FT REP

