


In its capacity as the U.S. Army Corps of Engineers, Charleston District Office, Special Data Branch has made this chart, including the information on this chart, available to the public. This information is provided for informational purposes only and is not intended to be used for navigation. The data on this chart were derived from the best available information and are not guaranteed to be accurate. The user assumes all responsibility for the use of this information. No liability is assumed for any errors or omissions. 


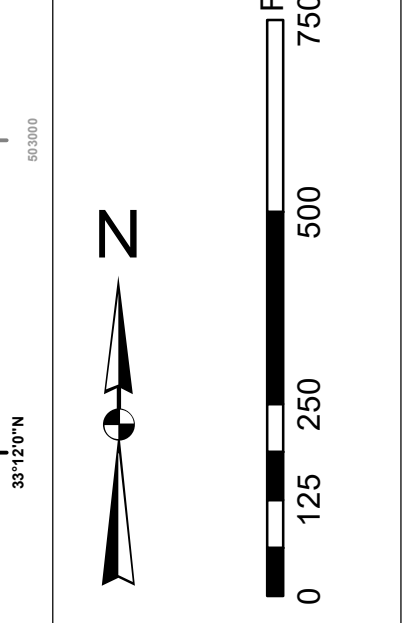







U.S. Army Corps of Engineers Charleston District Office Special Data Branch Charleston, SC 29405 CESAC-GIS@USACE.ARMY.MIL	Designed By: J. H. HARRIS Reviewed By: J. H. HARRIS Scale: 1 inch = 250 feet Projection: NAD 1983 StatePlane South Carolina FIPS 3900 Feet	Survey Date: 11 AUG 2022 Production Date: 15 AUG 2022 Project Reference Number: 20200010 Sheet Number: 001
---	---	---

**Georgetown Harbor Channel Survey**  
The information depicted on this map represents the results of surveys made on the dates indicated and can only be considered as indicating the general character of the bottom. No liability is assumed for any errors or omissions. This information is provided as a service to the public and is not intended to be used for navigation.  
Concluded on: 11 AUG 2022  
Georgetown, South Carolina

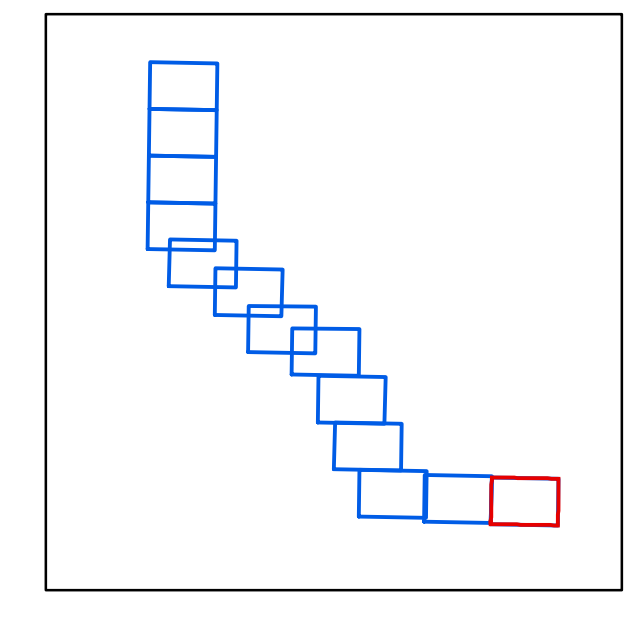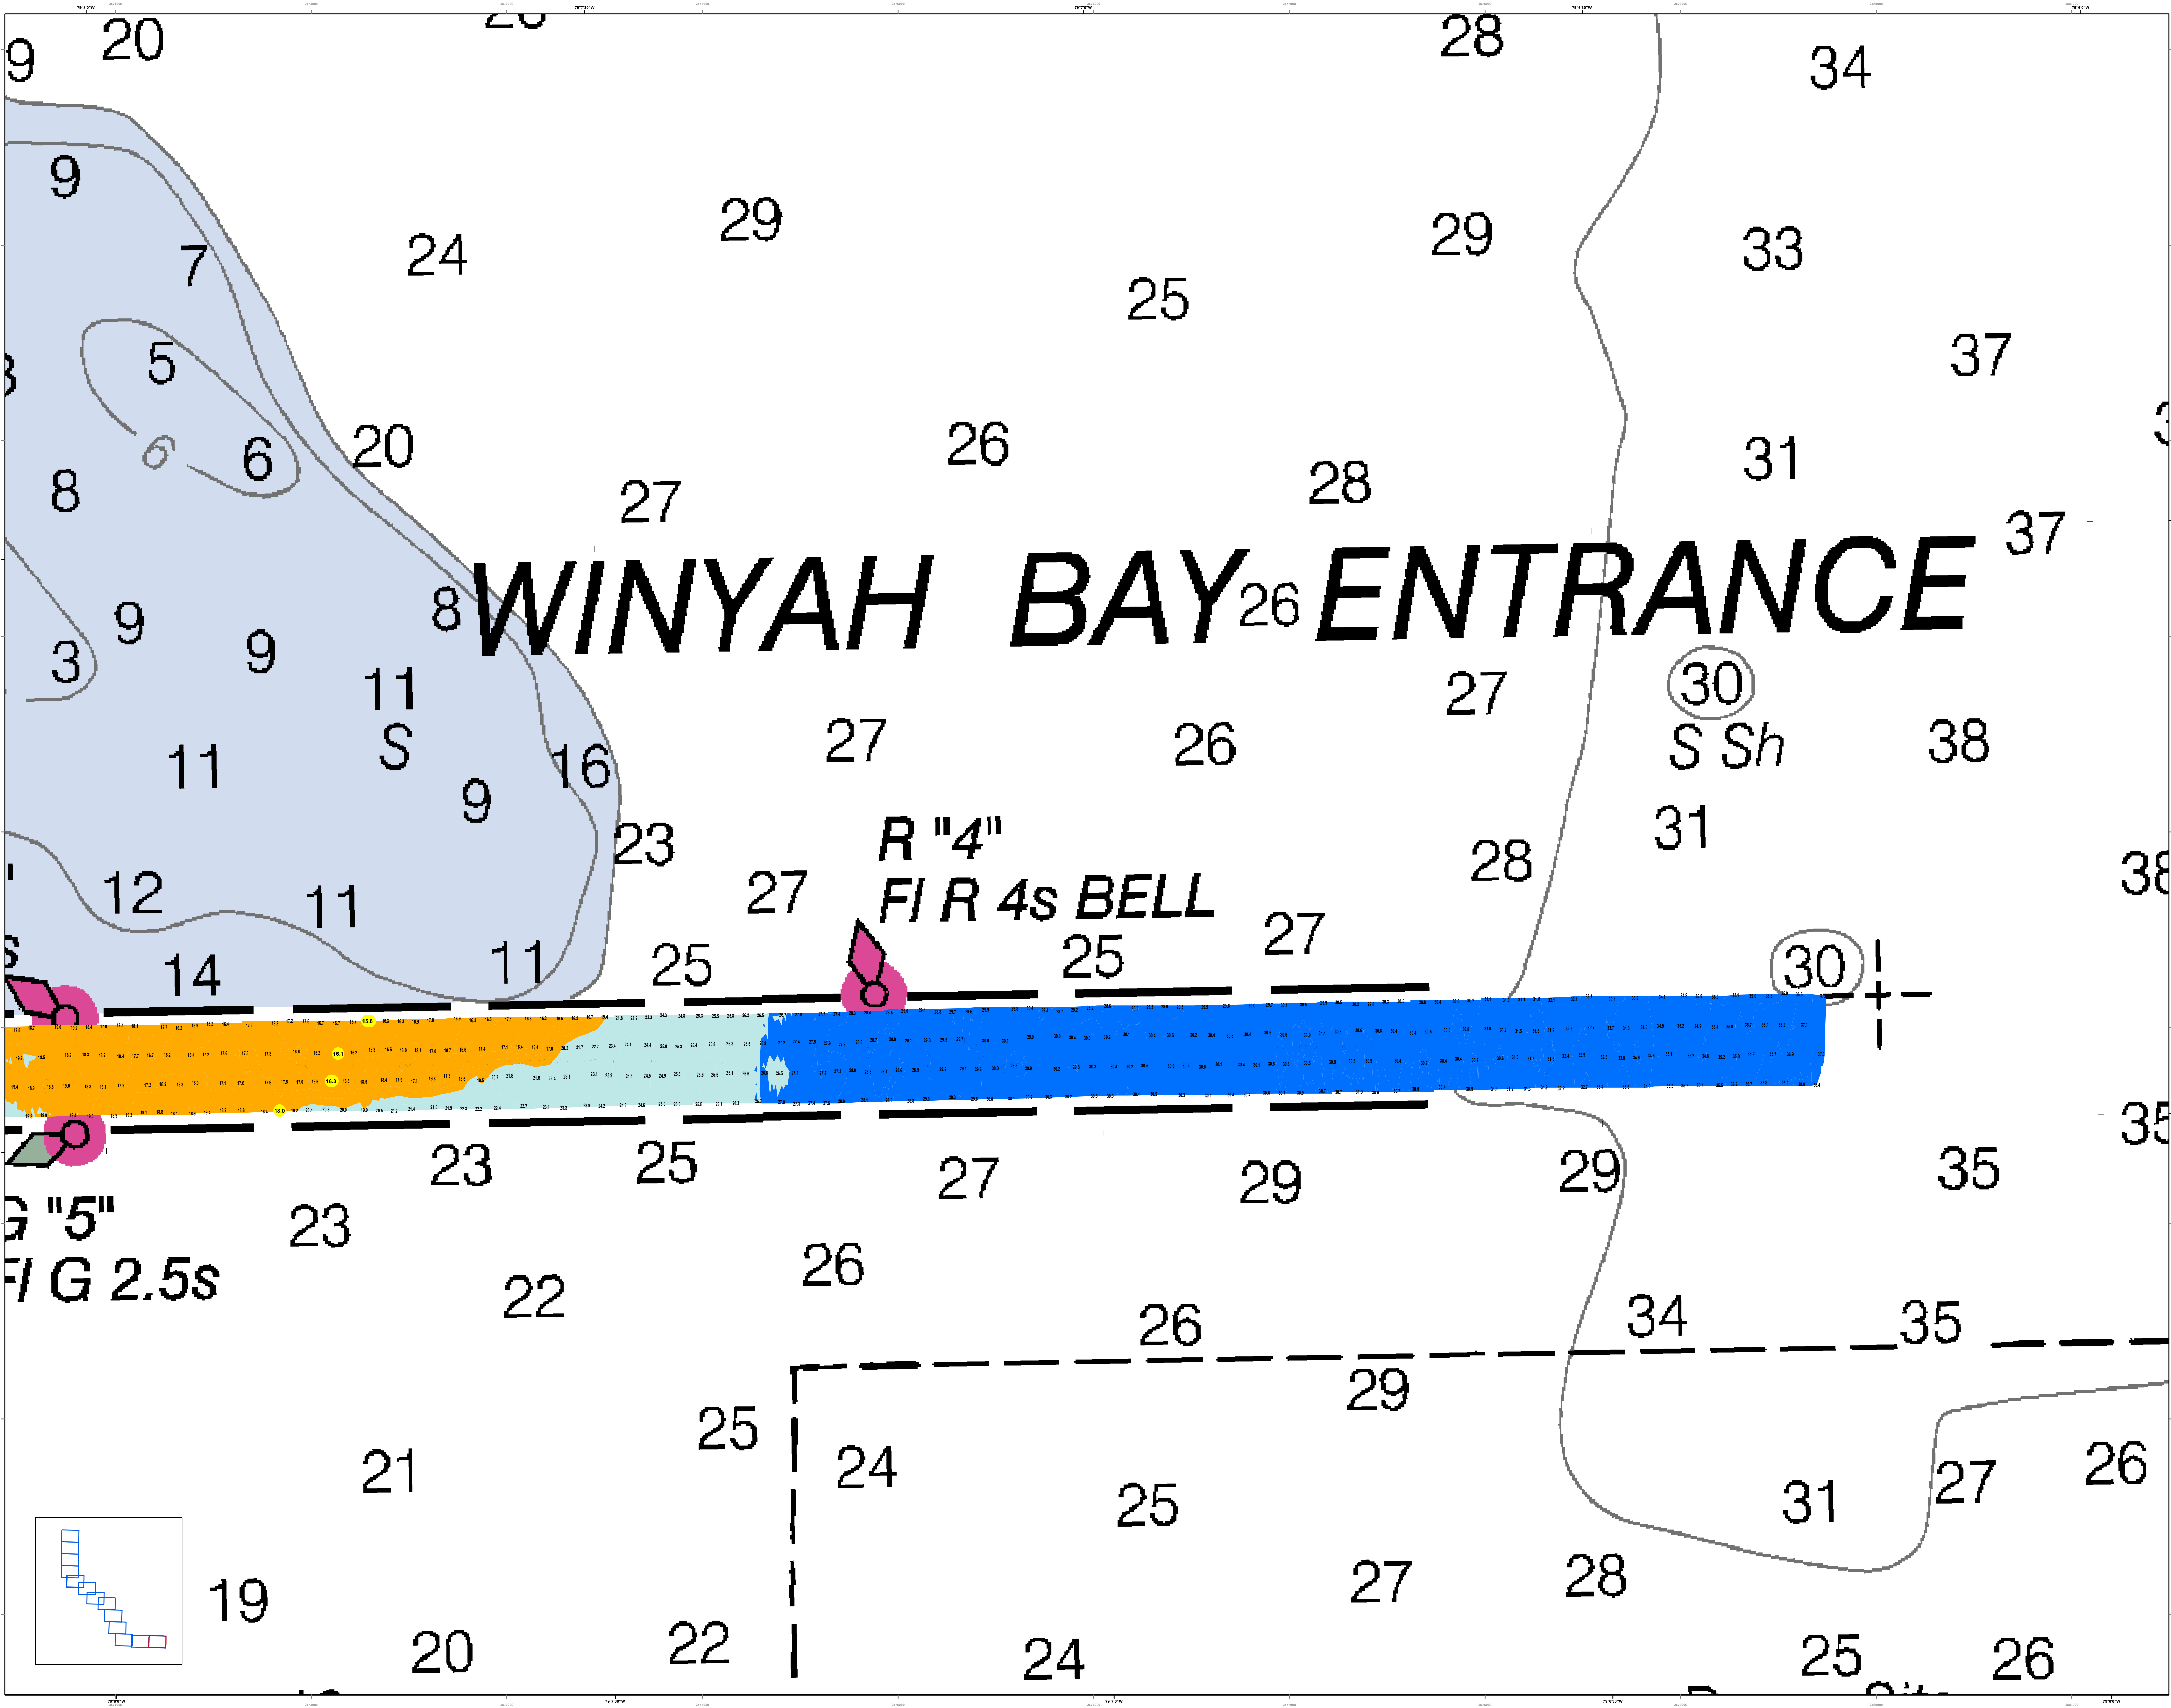


In its capacity as the U.S. Army Corps of Engineers, Charleston District Office, Special Data Branch has made this chart, including the information on this chart, available to the public. This information is provided for informational purposes only and is not intended to be used for navigation. The user assumes all responsibility for the use of this information. The Corps of Engineers is not liable for any damages, including consequential, arising from the use of this information. The information on this chart is not to be used for navigation. The user assumes all responsibility for the use of this information. The Corps of Engineers is not liable for any damages, including consequential, arising from the use of this information.

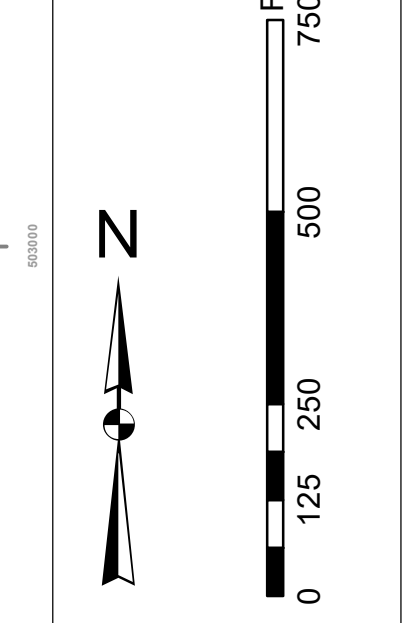




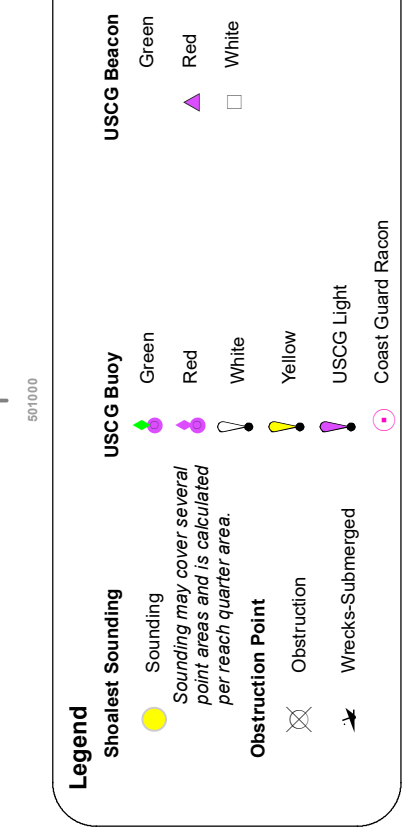


Designed By:	U.S. Army Corps of Engineers
Reviewed By:	U.S. Army Corps of Engineers
Scale:	1 inch = 250 feet
Projection:	NAD 1983 StatePlane South Carolina FIPS 3900 Feet
Survey Date:	11 AUG 2022
Production Date:	15 AUG 2022
Project Reference Number:	PC00010
Sheet Name:	CONDITION

**Georgetown Harbor Channel Survey**  
The information depicted on this map represents the results of surveys made on the dates indicated and can only be considered as indicating the general character of the bottom. The information on this chart is not to be used for navigation. The user assumes all responsibility for the use of this information. The Corps of Engineers is not liable for any damages, including consequential, arising from the use of this information.

Concluded on: 11 AUG 2022  
Georgetown, South Carolina

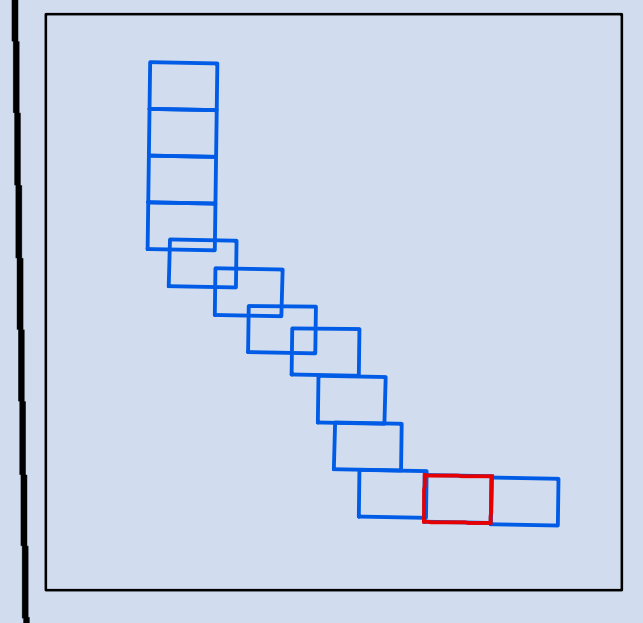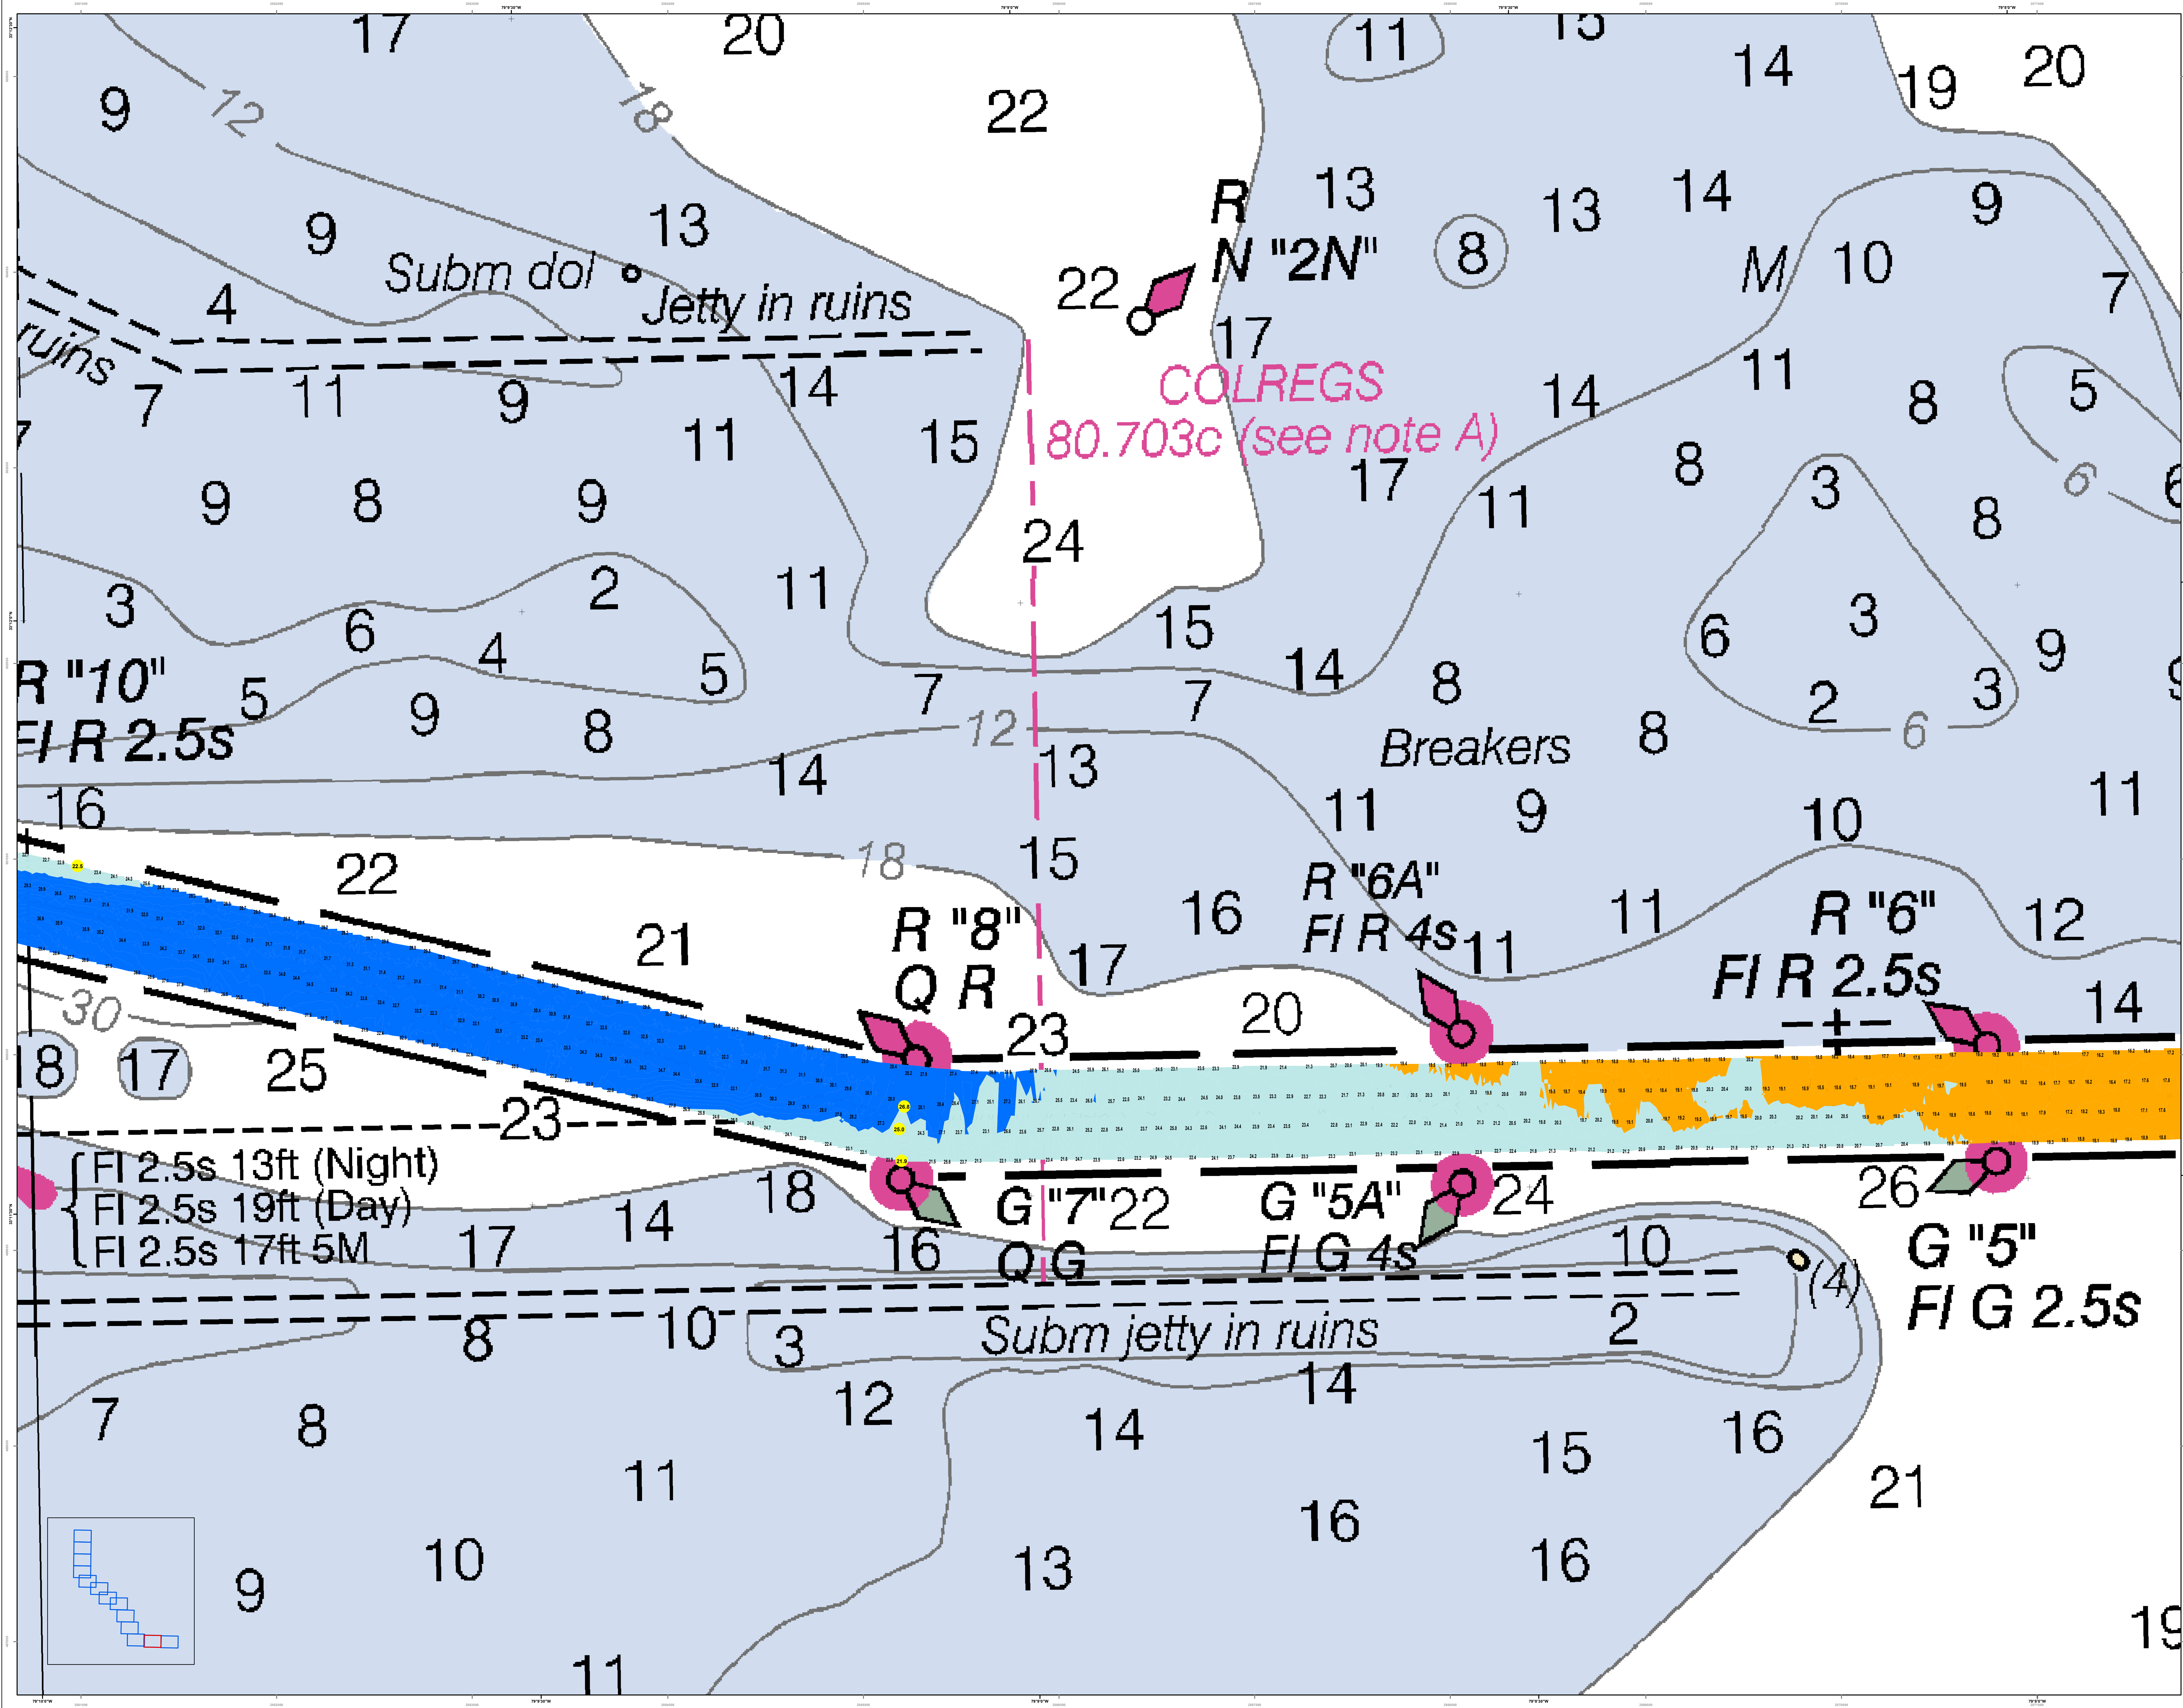

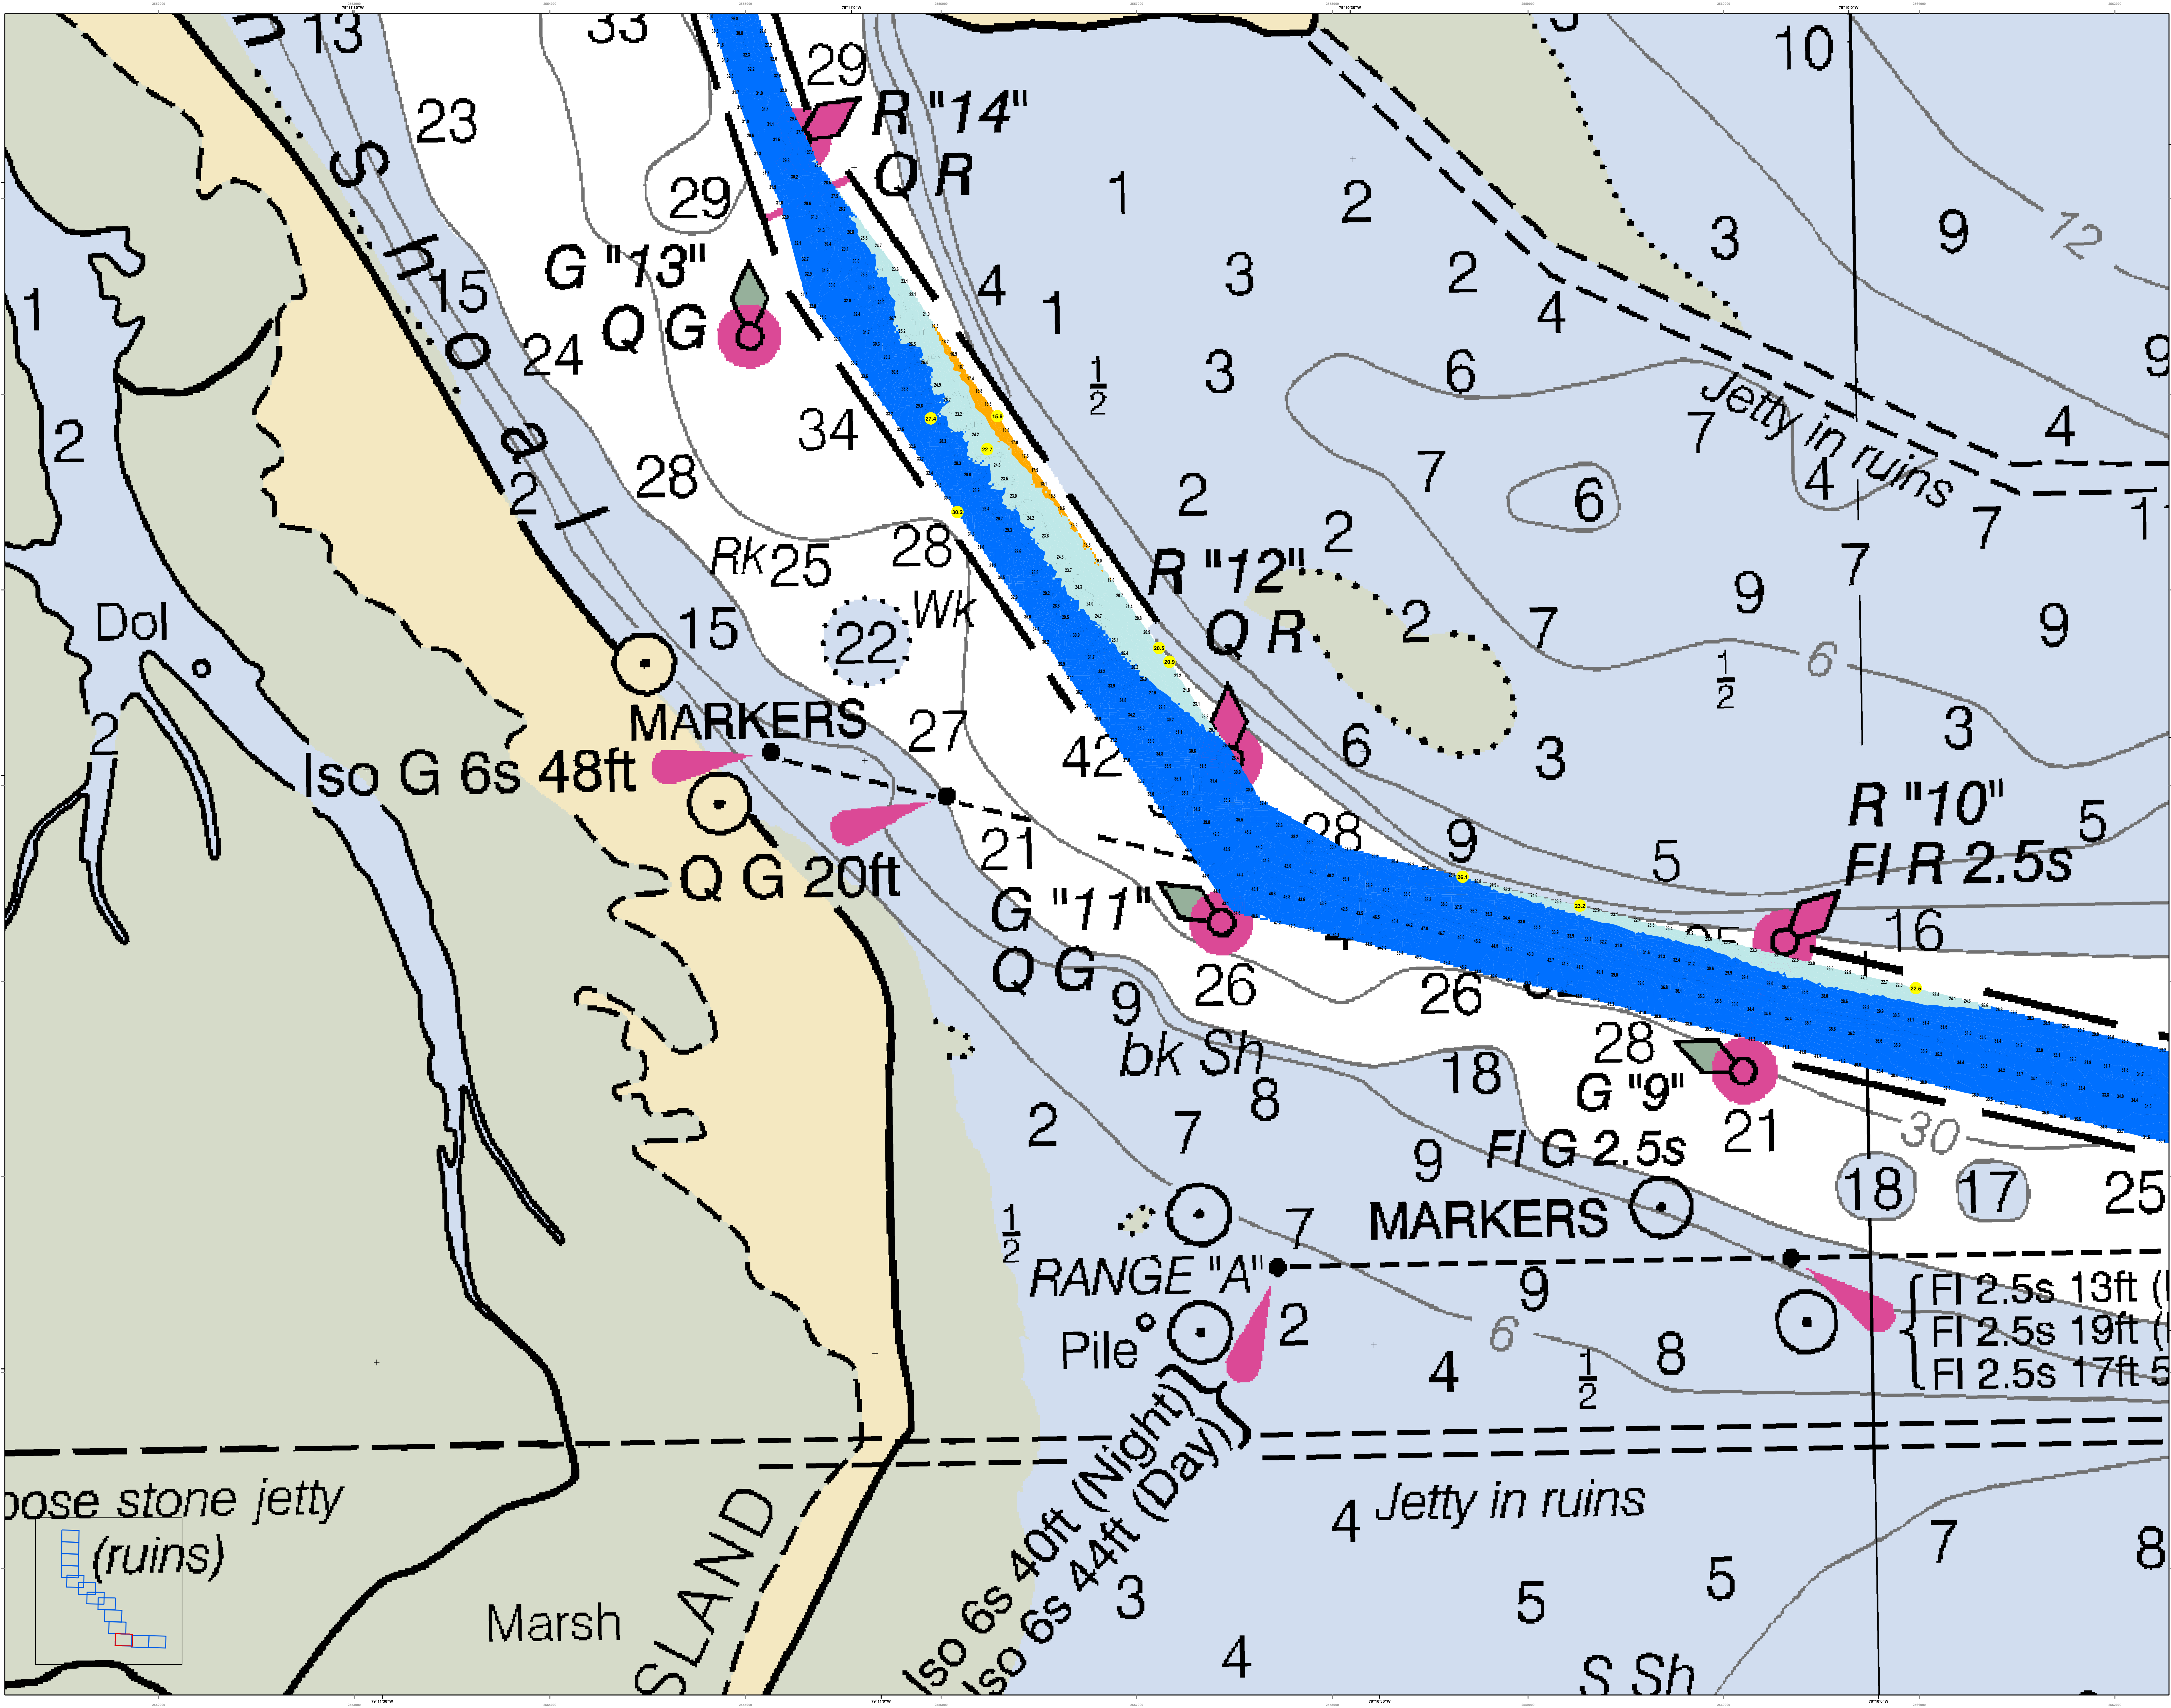

base stone jetty  
(ruins)

U.S. Army Corps of Engineers  
Charleston District


**Production Date:** 15 AUG 2022  
**Survey Date:** 11 AUG 2022  
**Project Reference Number:** 15000  
**Sheet Reference Number:** C001

**Scale:** 1 inch = 250 feet  
**Projection:** NAD 1983 StatePlane South Carolina FIPS 3800 Feet

**Legend:**

- Depth Contours: 10, 15, 20, 25, 30, 35, 40, 45, 50, 55, 60, 65, 70, 75, 80, 85, 90, 95, 100
- Navigation Aids: Iso G 6s 48ft, Iso G 20ft, Iso 6s 40ft (Night), Iso 6s 44ft (Day), R '14', R '12', R '10', G '13', G '11', G '9', FI G 2.5s, FI 2.5s 13ft, FI 2.5s 19ft, FI 2.5s 17ft-5
- Other Features: Jetty in ruins, SLAND, Marsh, Dol, Pile, RANGE 'A', MARKERS, bk Sh, S Sh

**Georgetown, South Carolina**  
 Concluded on: 11 AUG 2022  
 SHEET REFERENCE NUMBER: C001  
 SHEET 3 OF 13

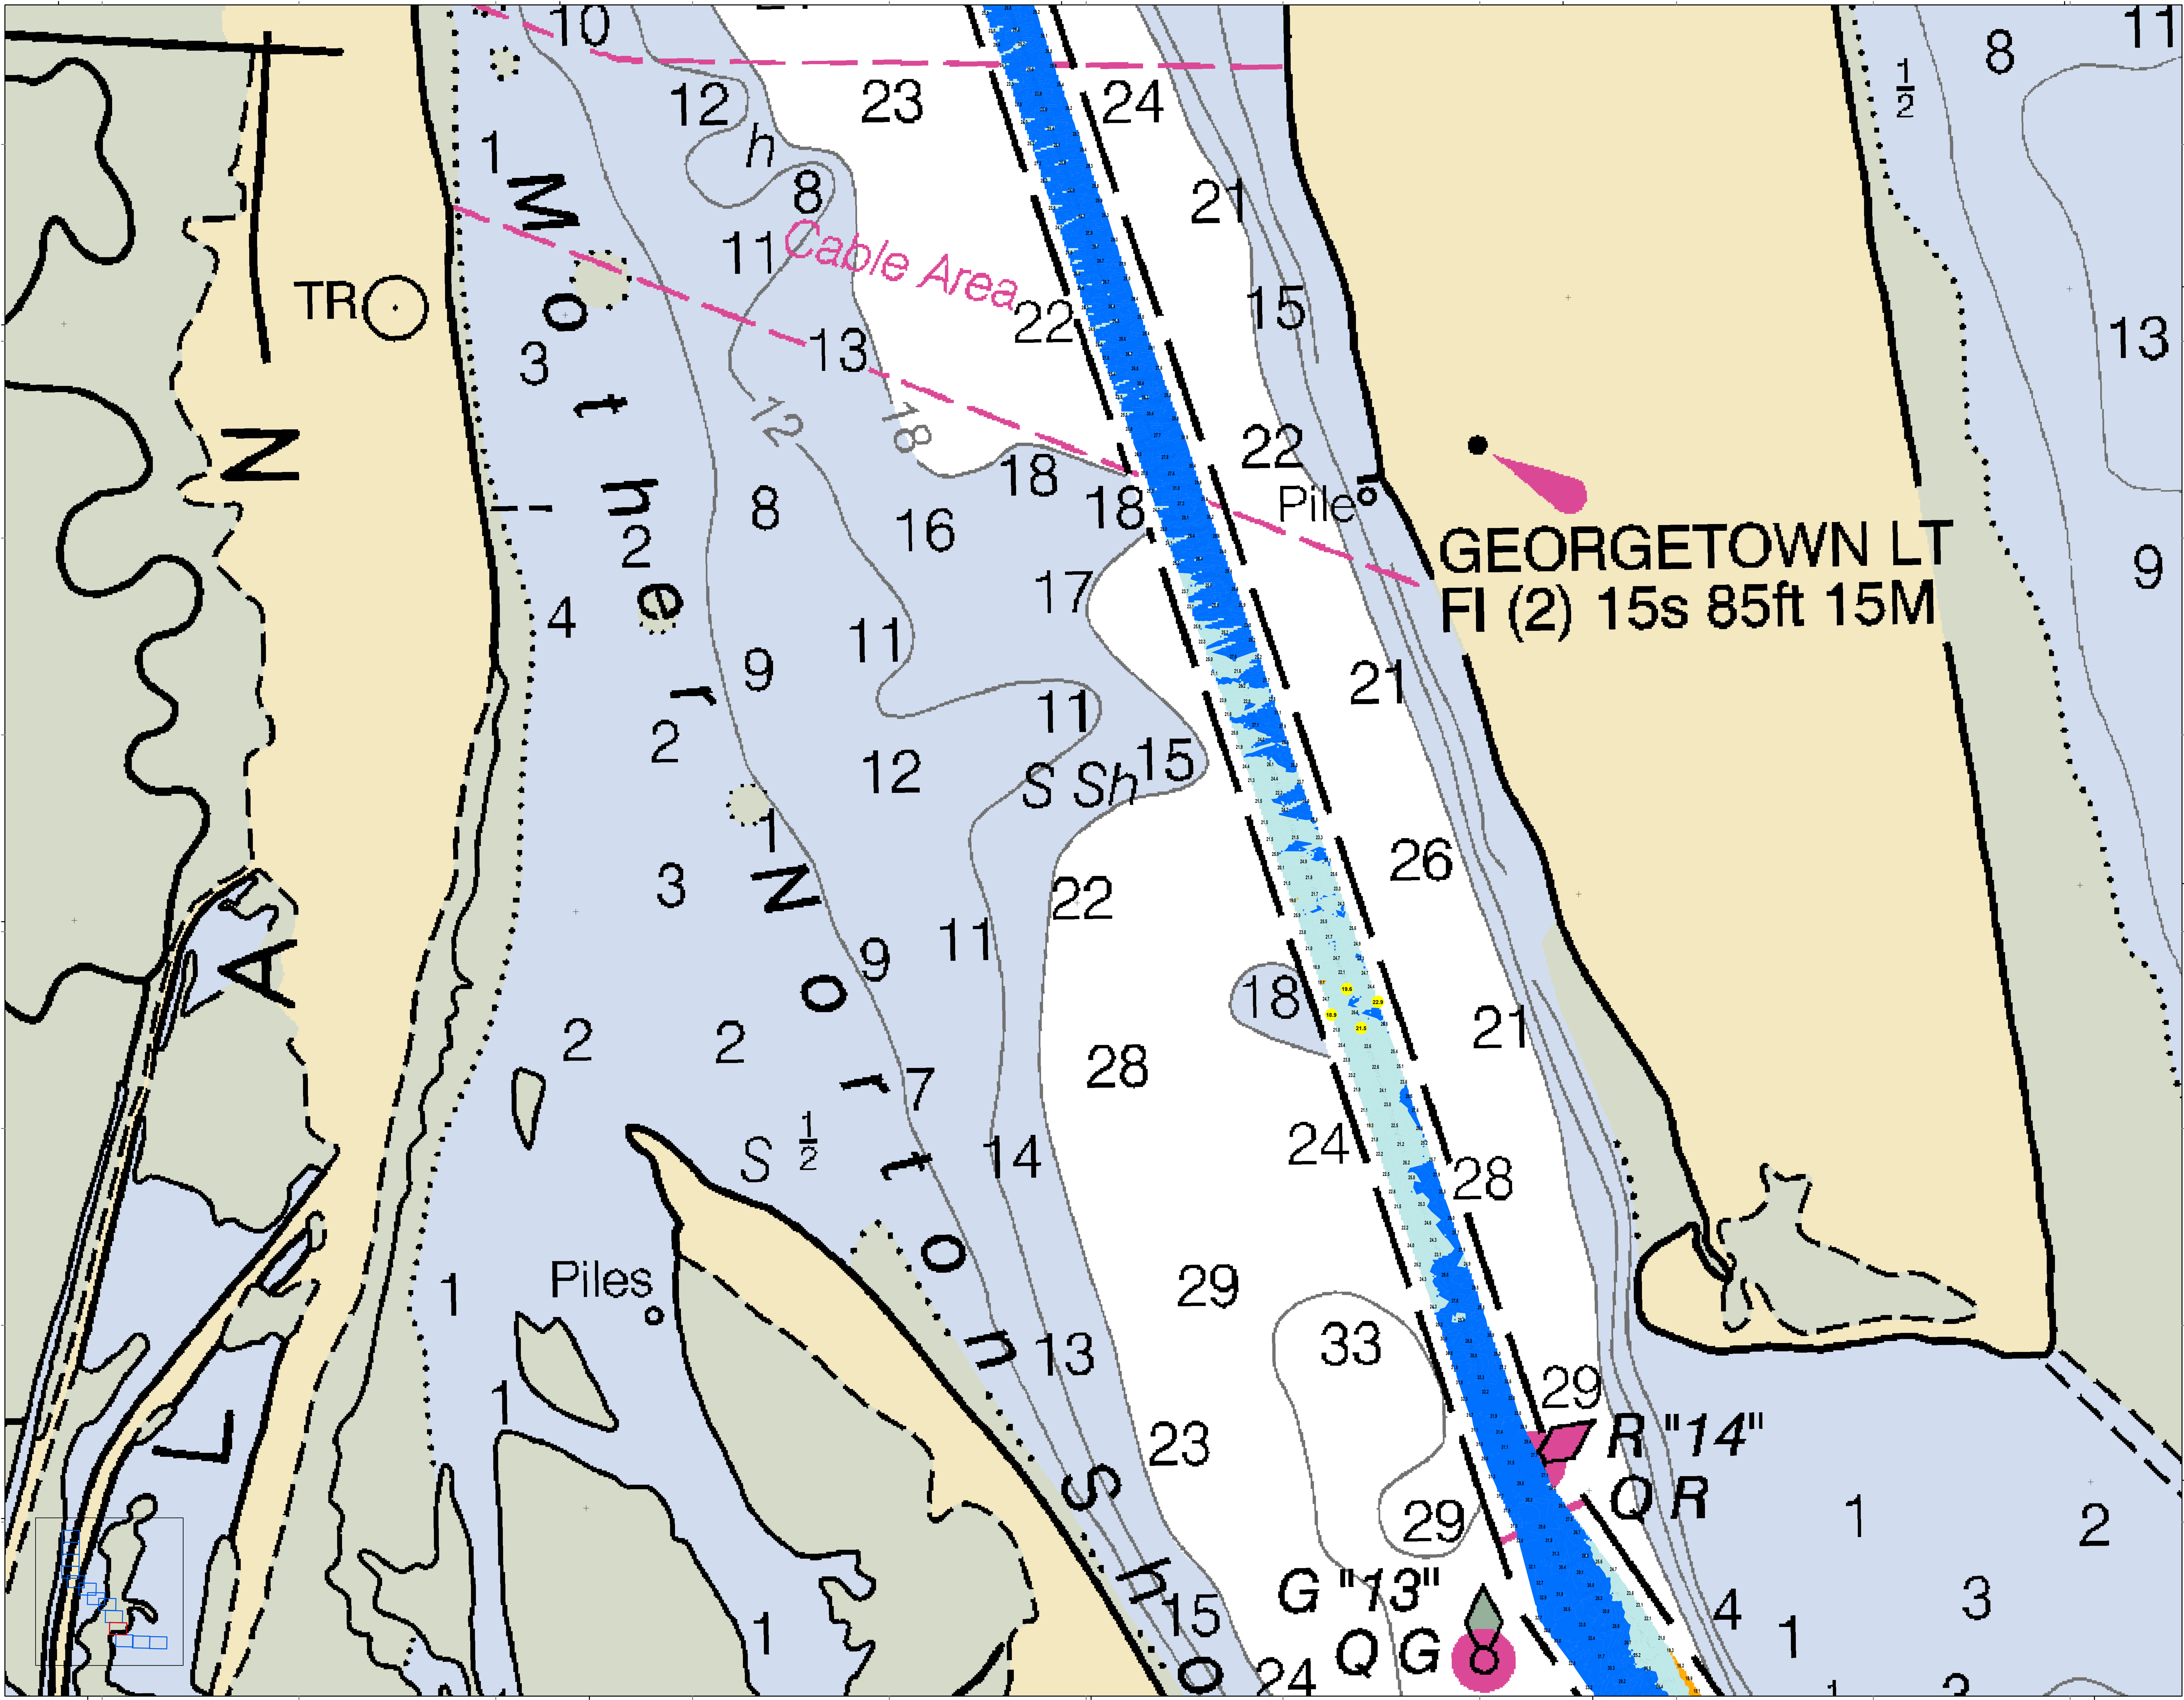

**U.S. Army Corps of Engineers**  
Charleston District

**Georgetown Harbor Channel Survey**  
The information depicted on this map represents the results of surveys made on the dates indicated and can only be considered as indicating the general character of the bottom. It is not intended to be used for navigation. Concluded on: 11 AUG 2022  
Georgetown, South Carolina

**Legend**

- Soundings:** 1 to 10, 11 to 15, 16 to 20, 21 to 25, 26 to 30, 31 to 35
- Depth Contours:** 10, 15, 20, 25, 30, 35
- Obstructions:** Pile, Piles, Light
- Other:** Cable Area, Light Structure


**Scale:** 1 inch = 250 feet

**Production Date:** 15 AUG 2022  
**Project Reference Number:** P000010  
**Survey Station:** CONDITION

Designed By:	U.S. Army Corps of Engineers
Reviewed By:	Charleston District
Scale:	1 inch = 250 feet
Projection:	NAD 1983 StatePlane South Carolina FIPS 3900 Feet

**U.S. Army Corps of Engineers**  
Charleston District  
Charleston, SC 29403  
CESAC-GIS@USACE.ARMY.MIL

**SHEET REFERENCE NUMBER**  
C001  
SHEET 4 OF 13

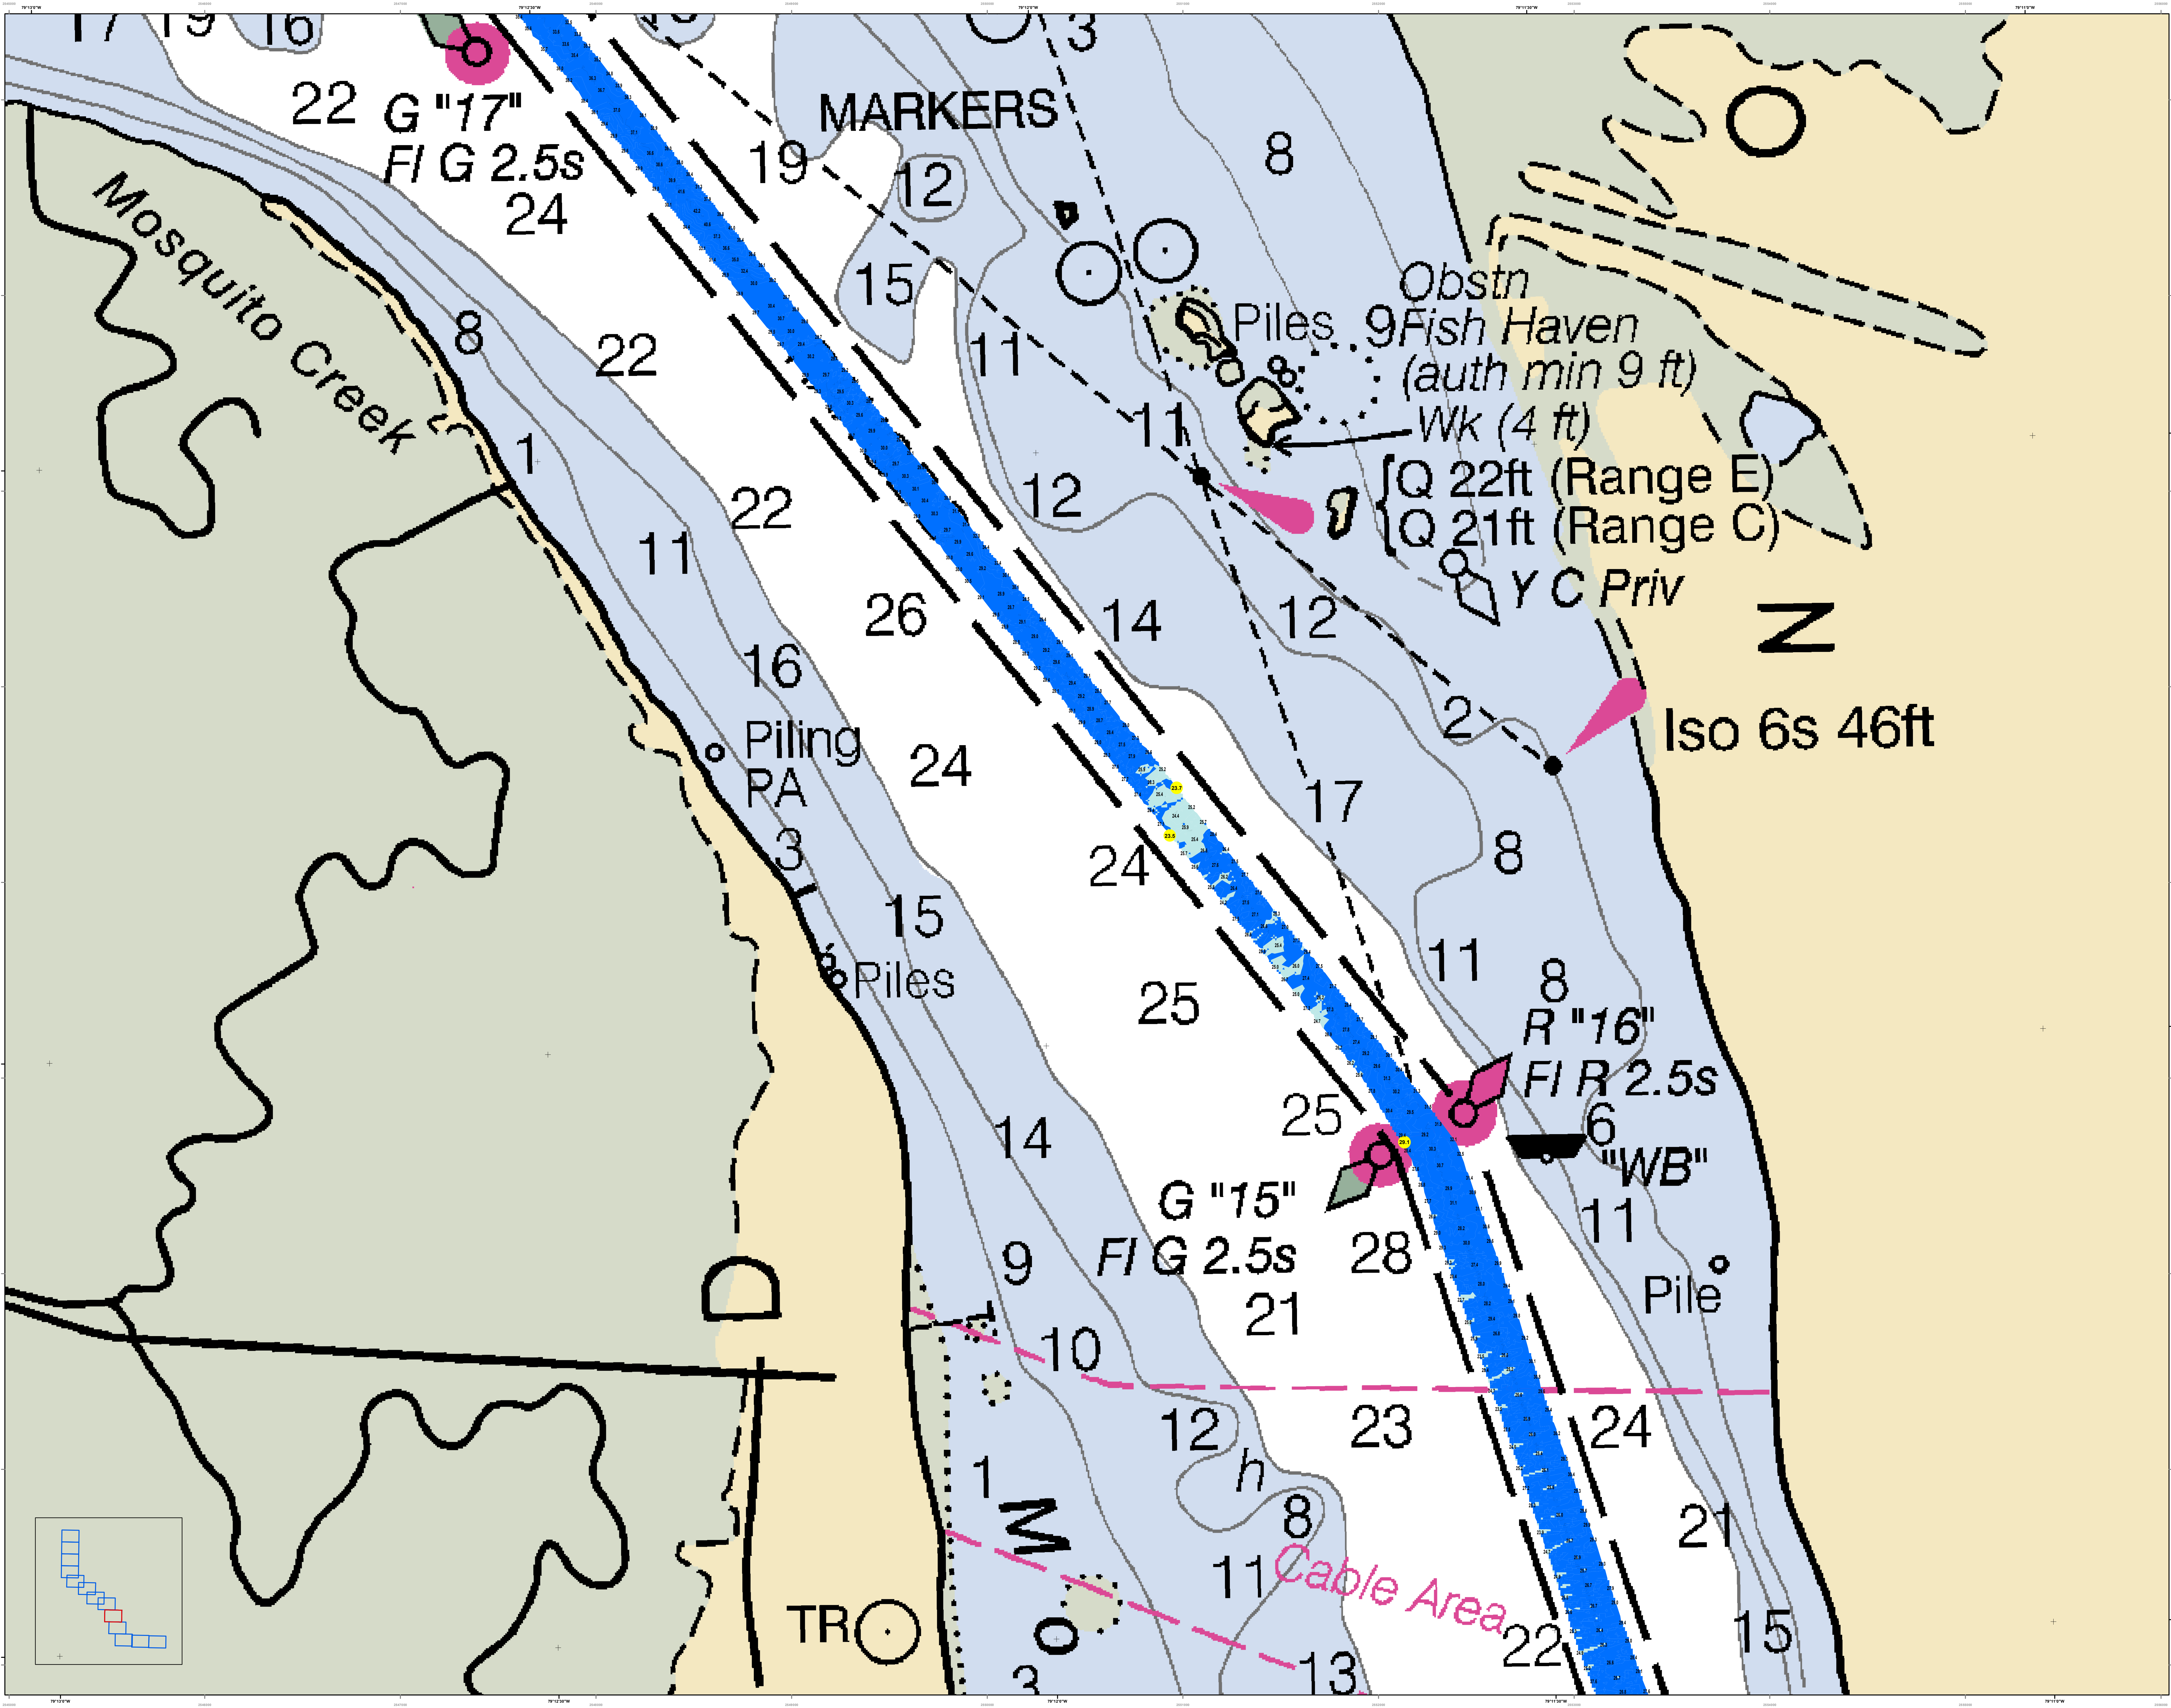

U.S. Army Corps of Engineers  
Charleston District




**Legend:**  


- Obstn Piles
- Y C Priv
- Iso 6s 46ft
- R "16" FIR 2.5s
- G "15" FIG 2.5s
- G "17" FIG 2.5s
- Mosquito Creek
- Piling PA
- Piles
- TRO
- Cable Area

**Metadata:**  

U.S. Army Corps of Engineers	Charleston District	Georgetown, South Carolina	
Survey Date:	11 AUG 2022	Production Date:	15 AUG 2022
Revised Date:	11 AUG 2022	Survey Status:	CONDITION
Projection:	NAD 1983 StatePlane South Carolina FIPS 3800 Feet		

**Georgetown Harbor Channel Survey**  
 The information depicted on this map represents the results of surveys made on the dates indicated and can only be considered as indicating the general character of the bottom. It is not to be used for navigation. It is for informational purposes only.  
 Concluded on: 11 AUG 2022  
 Georgetown, South Carolina

SHEET REFERENCE NUMBER: C001  
 SHEET 5 OF 13

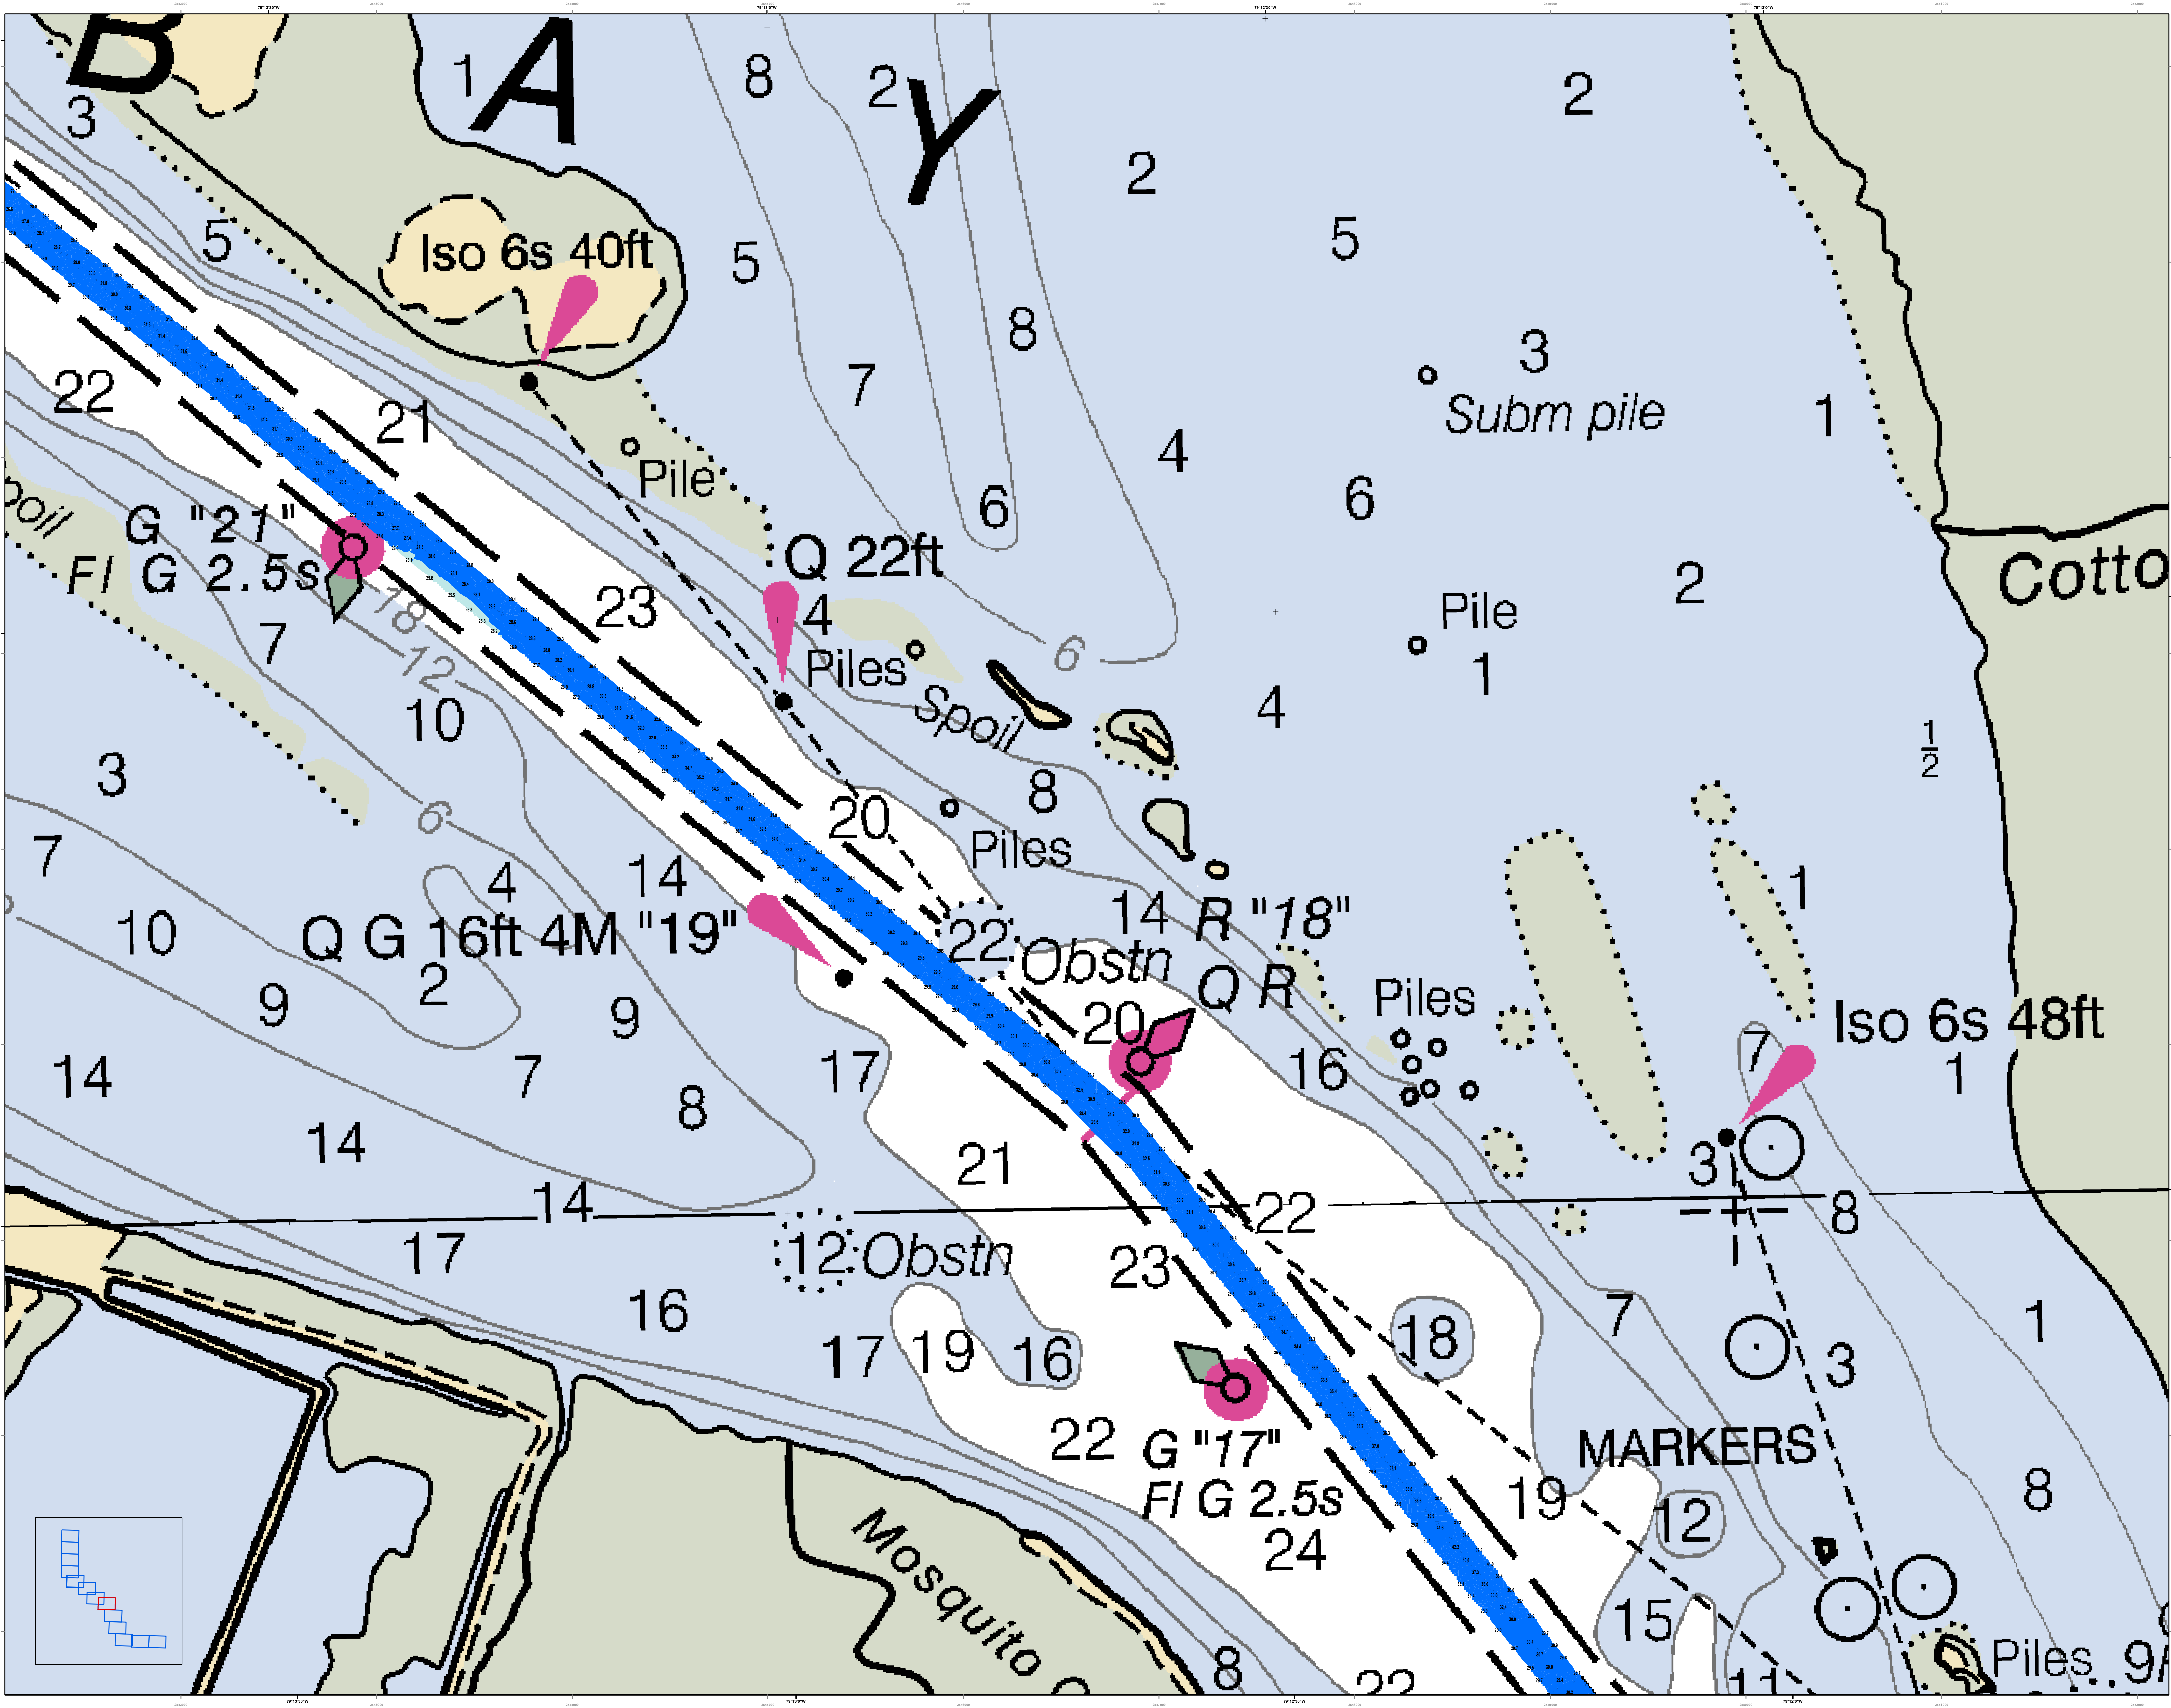

U.S. Army Corps of Engineers  
Charleston District

**Georgetown Harbor Channel Survey**  
The information depicted on this map represents the results of surveys made on the dates indicated and can only be considered as indicating the general location of obstructions. It is not intended to be used for navigation.

Concluded on: 11 AUG 2022  
Georgetown, South Carolina


Produced by: 11 AUG 2022 15 AUG 2022  
Project Reference Number: 2020010  
Survey State: CONDITION


Designed By: U.S. Army Corps of Engineers  
Reviewed By: U.S. Army Corps of Engineers  
Scale: 1:50,000  
Projection: NAD 1983 StatePlane South Carolina FIPS 3800 Feet

Legend:  

Scale: 0 125 250 500 750 Feet

North Arrow

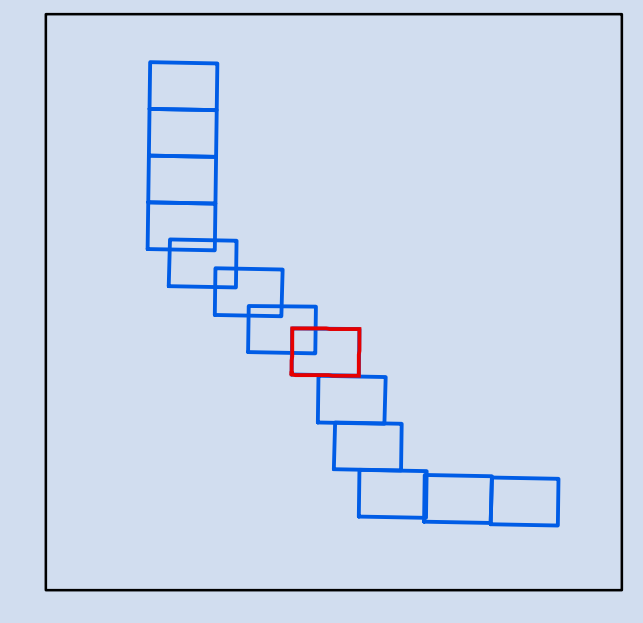


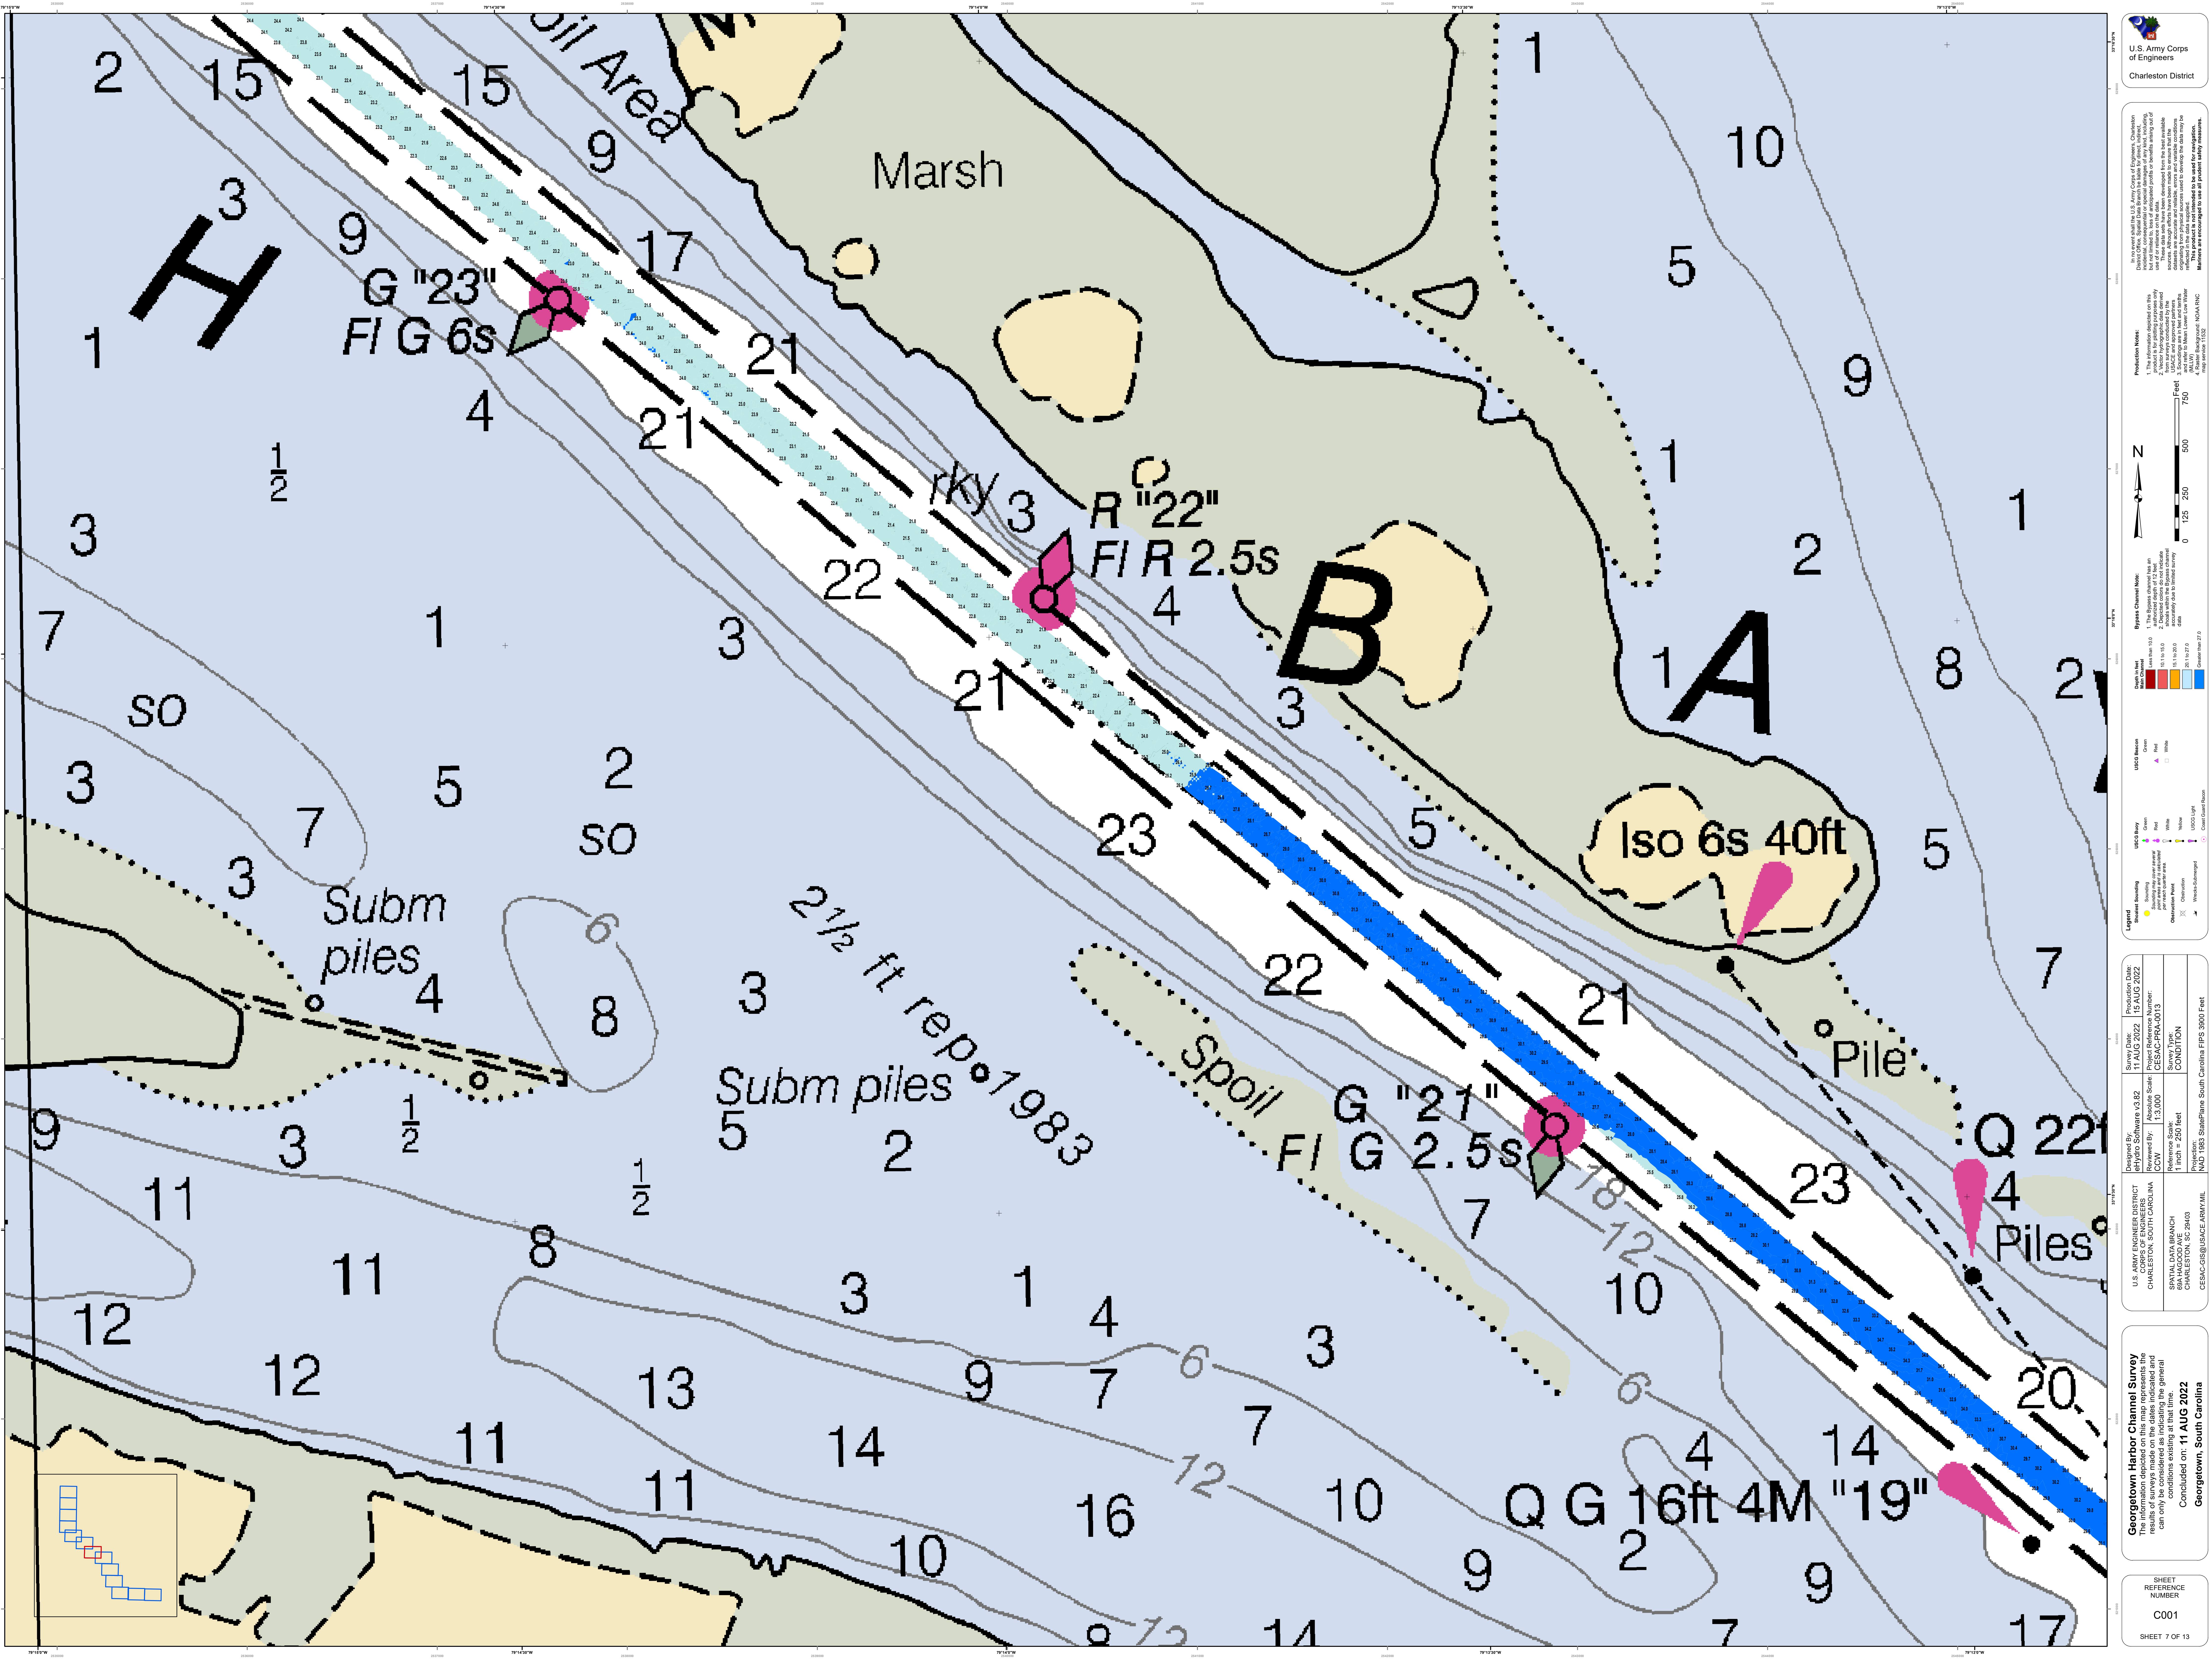

U.S. Army Corps of Engineers  
Charleston District



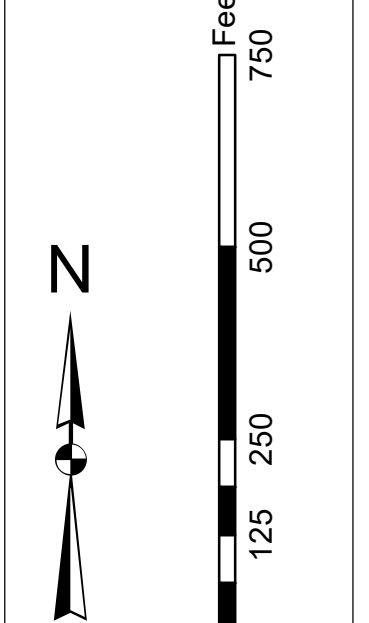




Designed By:	U.S. Army Corps of Engineers, Charleston District
Reviewed By:	U.S. Army Corps of Engineers, Charleston District
Scale:	1 inch = 250 feet
Projection:	NAD 1983 StatePlane South Carolina FIPS 3800 Feet


<b>Georgetown Harbor Channel Survey</b>	Production Date: 15 AUG 2022
The information depicted on this map represents the results of surveys made on the dates indicated and can only be considered as indicating the general nature of the channel and adjacent areas.	Project Reference Number: 10400010
Concluded on: 11 AUG 2022	Survey Status: CONDITION

Georgetown, South Carolina  
SHEET REFERENCE NUMBER  
C001  
SHEET 7 OF 13

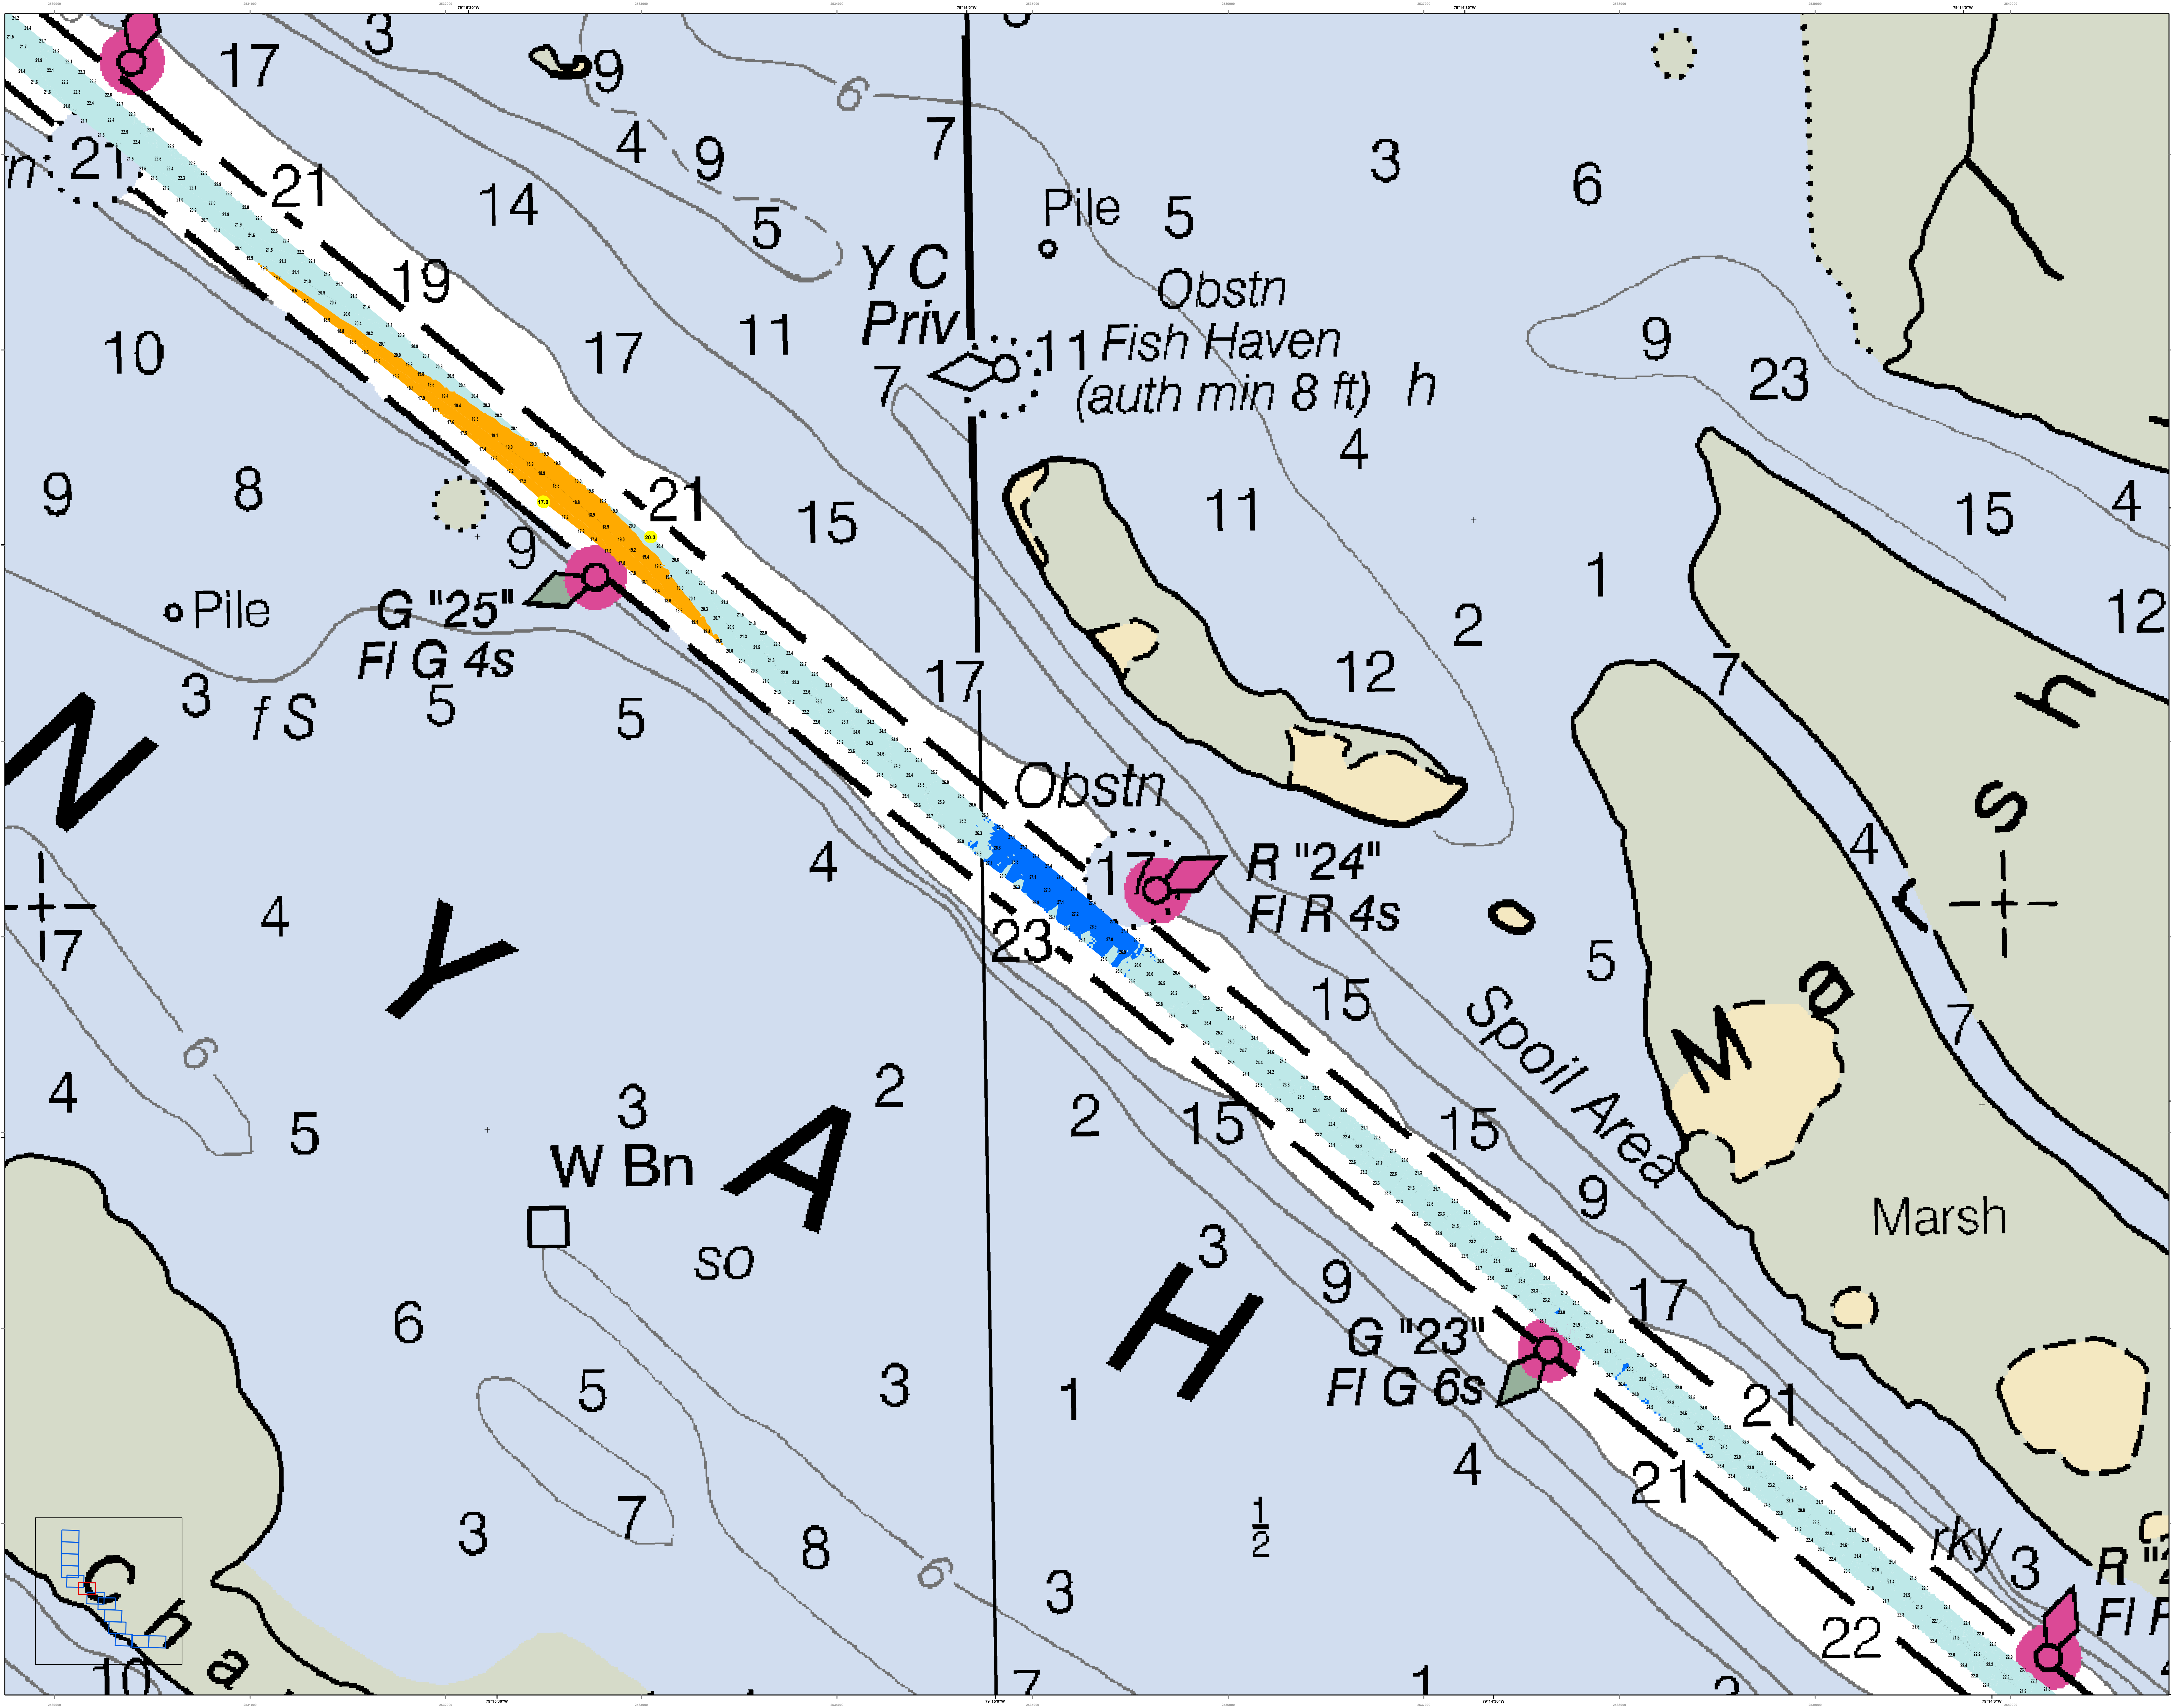

In its capacity as the U.S. Army Corps of Engineers, Charleston District Office, Special Data Branch has made this chart, including the information on this chart, available to the public. This information is provided for informational purposes only and does not constitute a warranty of any kind. 

**Production Notes:**  

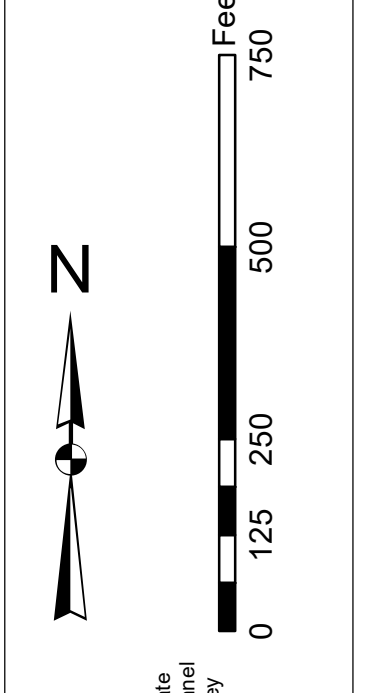

**Production Date:** 15 AUG 2022  
**Survey Date:** 11 AUG 2022  
**Project Reference Number:** P000010  
**Sheet Title:** CHANNEL  
**Condition:** CONDITION


**Projection:** NAD 1983 StatePlane South Carolina FIPS 3800 Feet

**U.S. Army Corps of Engineers District Office**  
CHARLESTON DISTRICT OFFICE  
SPECIAL DATA BRANCH  
CESACGIS@USACE.ARMY.MIL

**Georgetown Harbor Channel Survey**  
The information depicted on this map represents the results of surveys made on the dates indicated and can only be considered as indicating the general character of the bottom. It is not to be used for navigation.  
Concluded on: 11 AUG 2022  
Georgetown, South Carolina





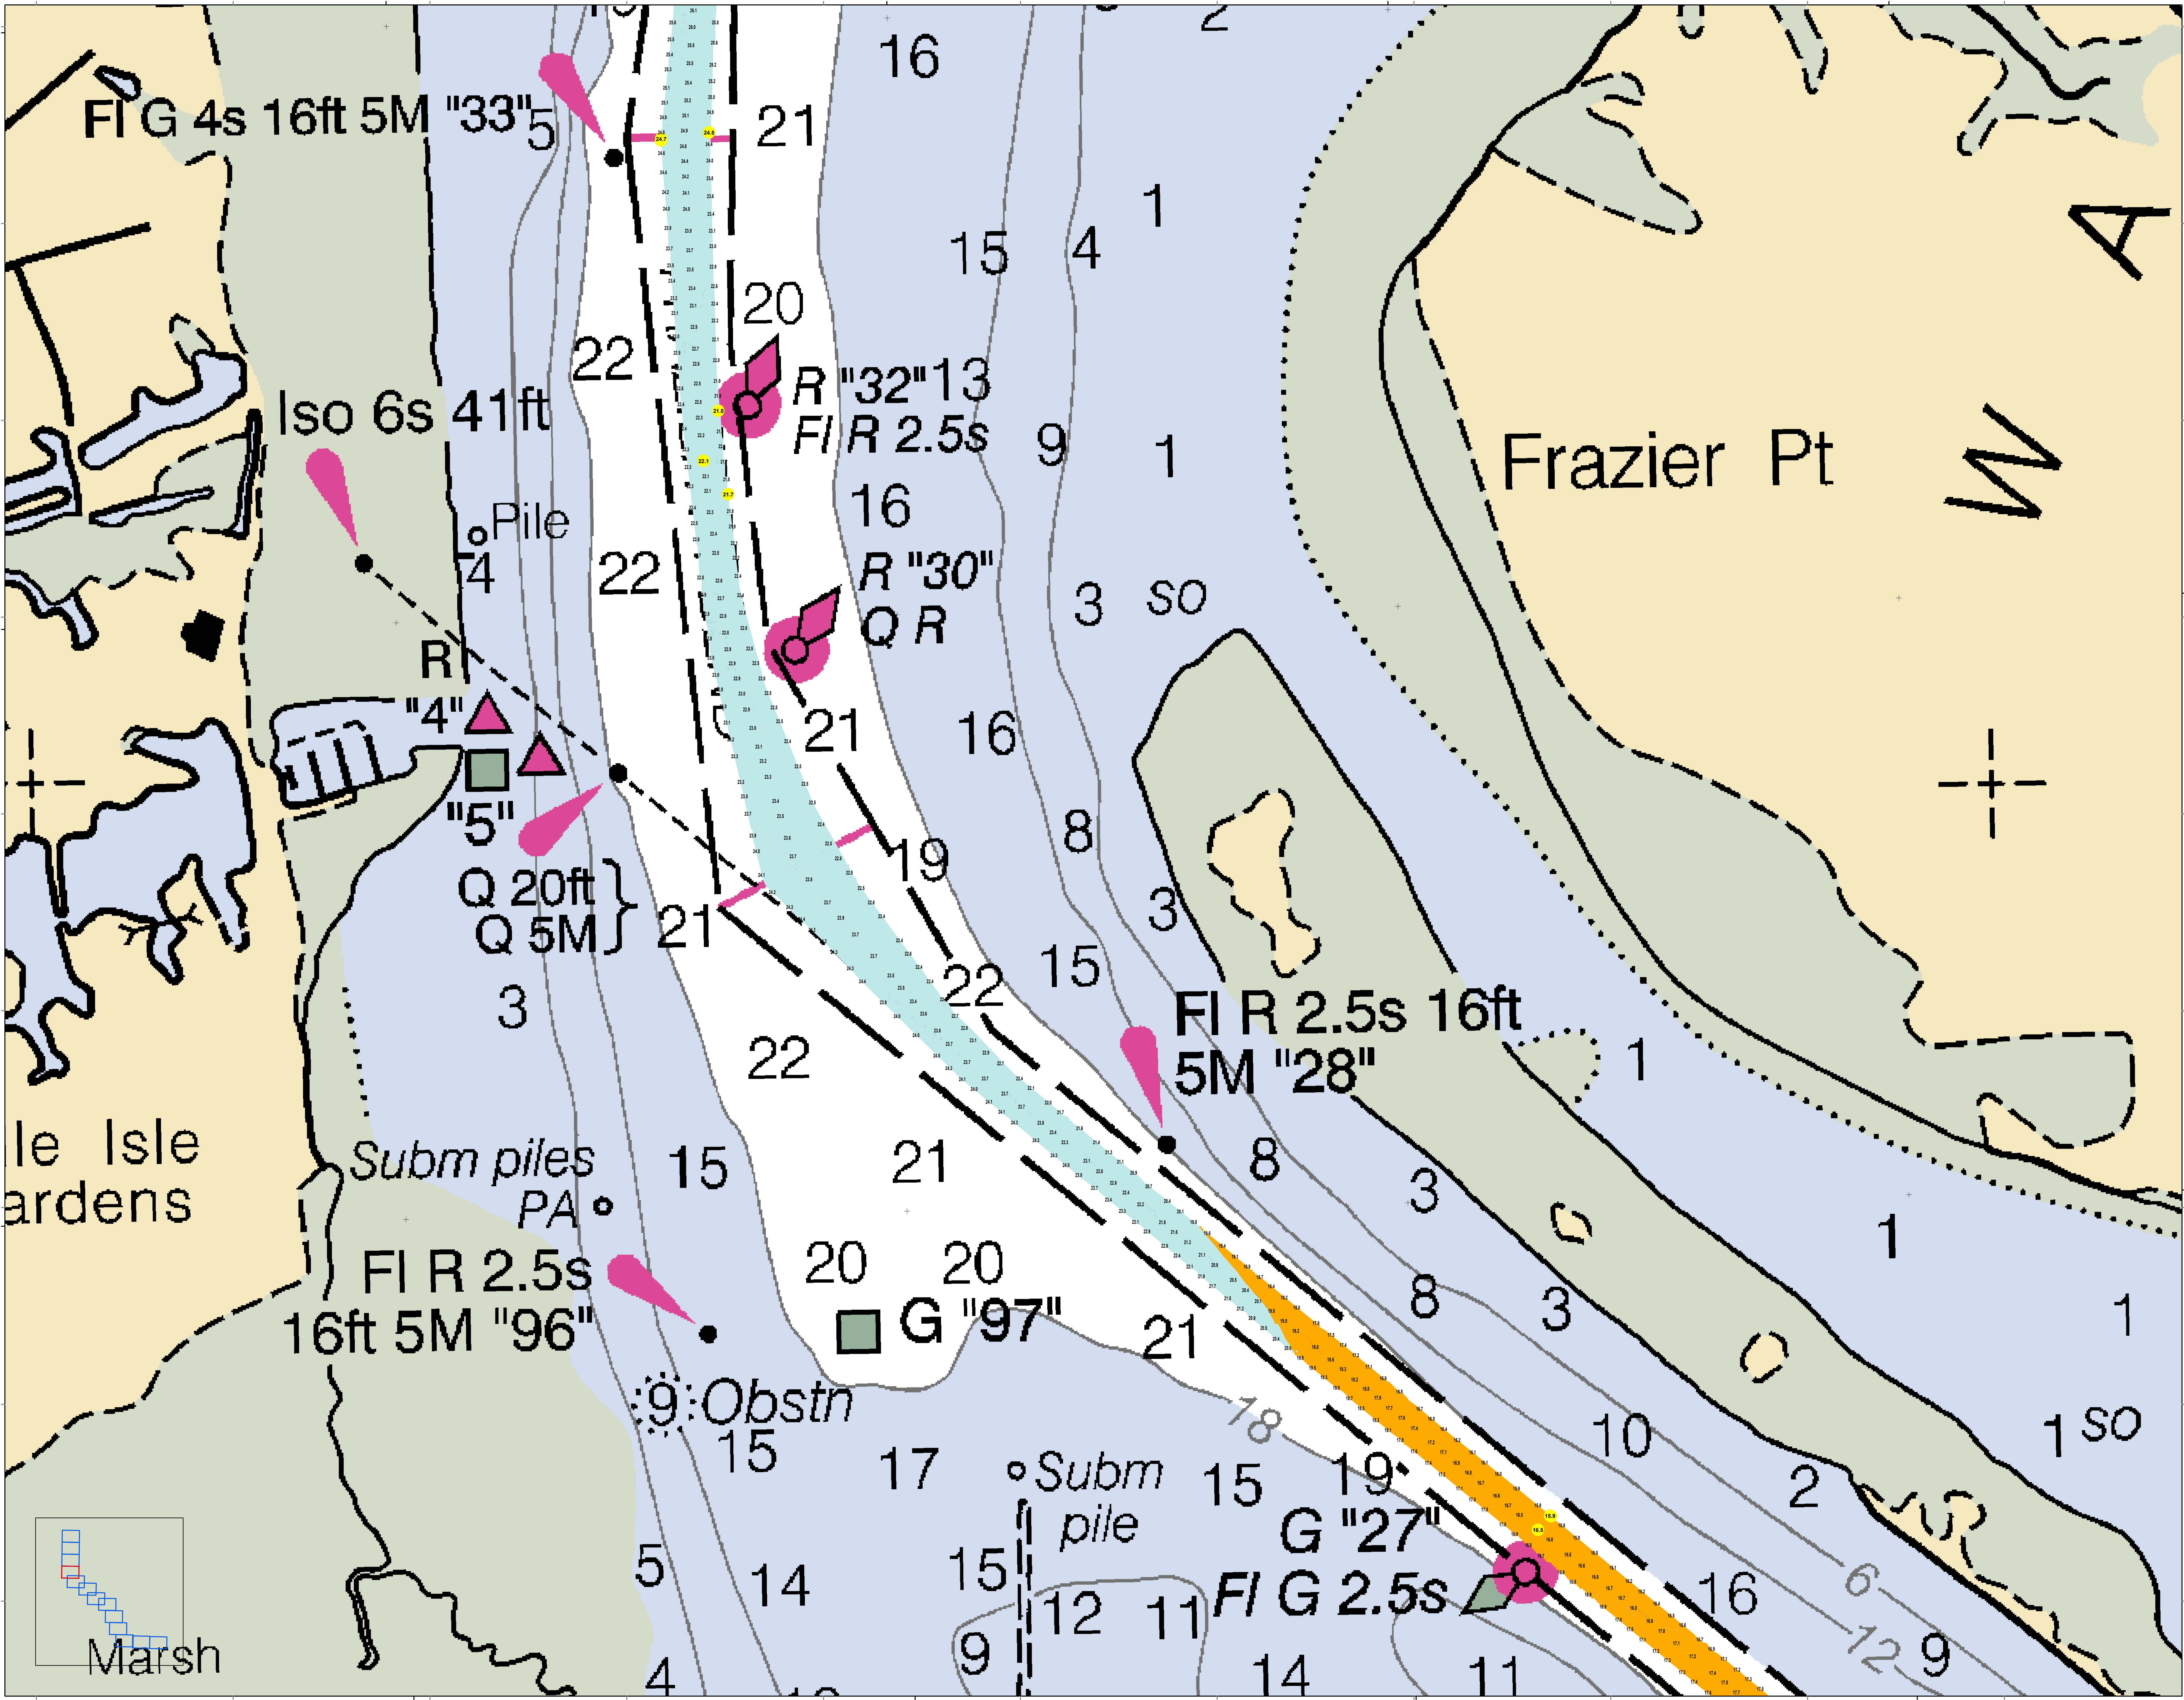

**U.S. Army Corps of Engineers**  
Charleston District

**Production Date:** 11 AUG 2022 | 15 AUG 2022  
**Project Reference Number:** 15030  
**Survey Station:** 15030  
**Condition:** CONDITION

**Designed By:** U.S. Army Corps of Engineers, District Office, Charleston, SC  
**Reviewed By:** U.S. Army Corps of Engineers, District Office, Charleston, SC  
**Scale:** 1 inch = 250 feet  
**Projection:** NAD 1983 StatePlane South Carolina FIPS 3800 Feet

**Georgetown Harbor Channel Survey**  
 The information depicted on this map represents the results of surveys made on the dates indicated and can only be considered as indicating the general location of objects. It is not intended to be used for navigation.  
 Concluded on: 11 AUG 2022  
 Georgetown, South Carolina






**Sheet Reference Number:** C001  
**Sheet 10 of 13**

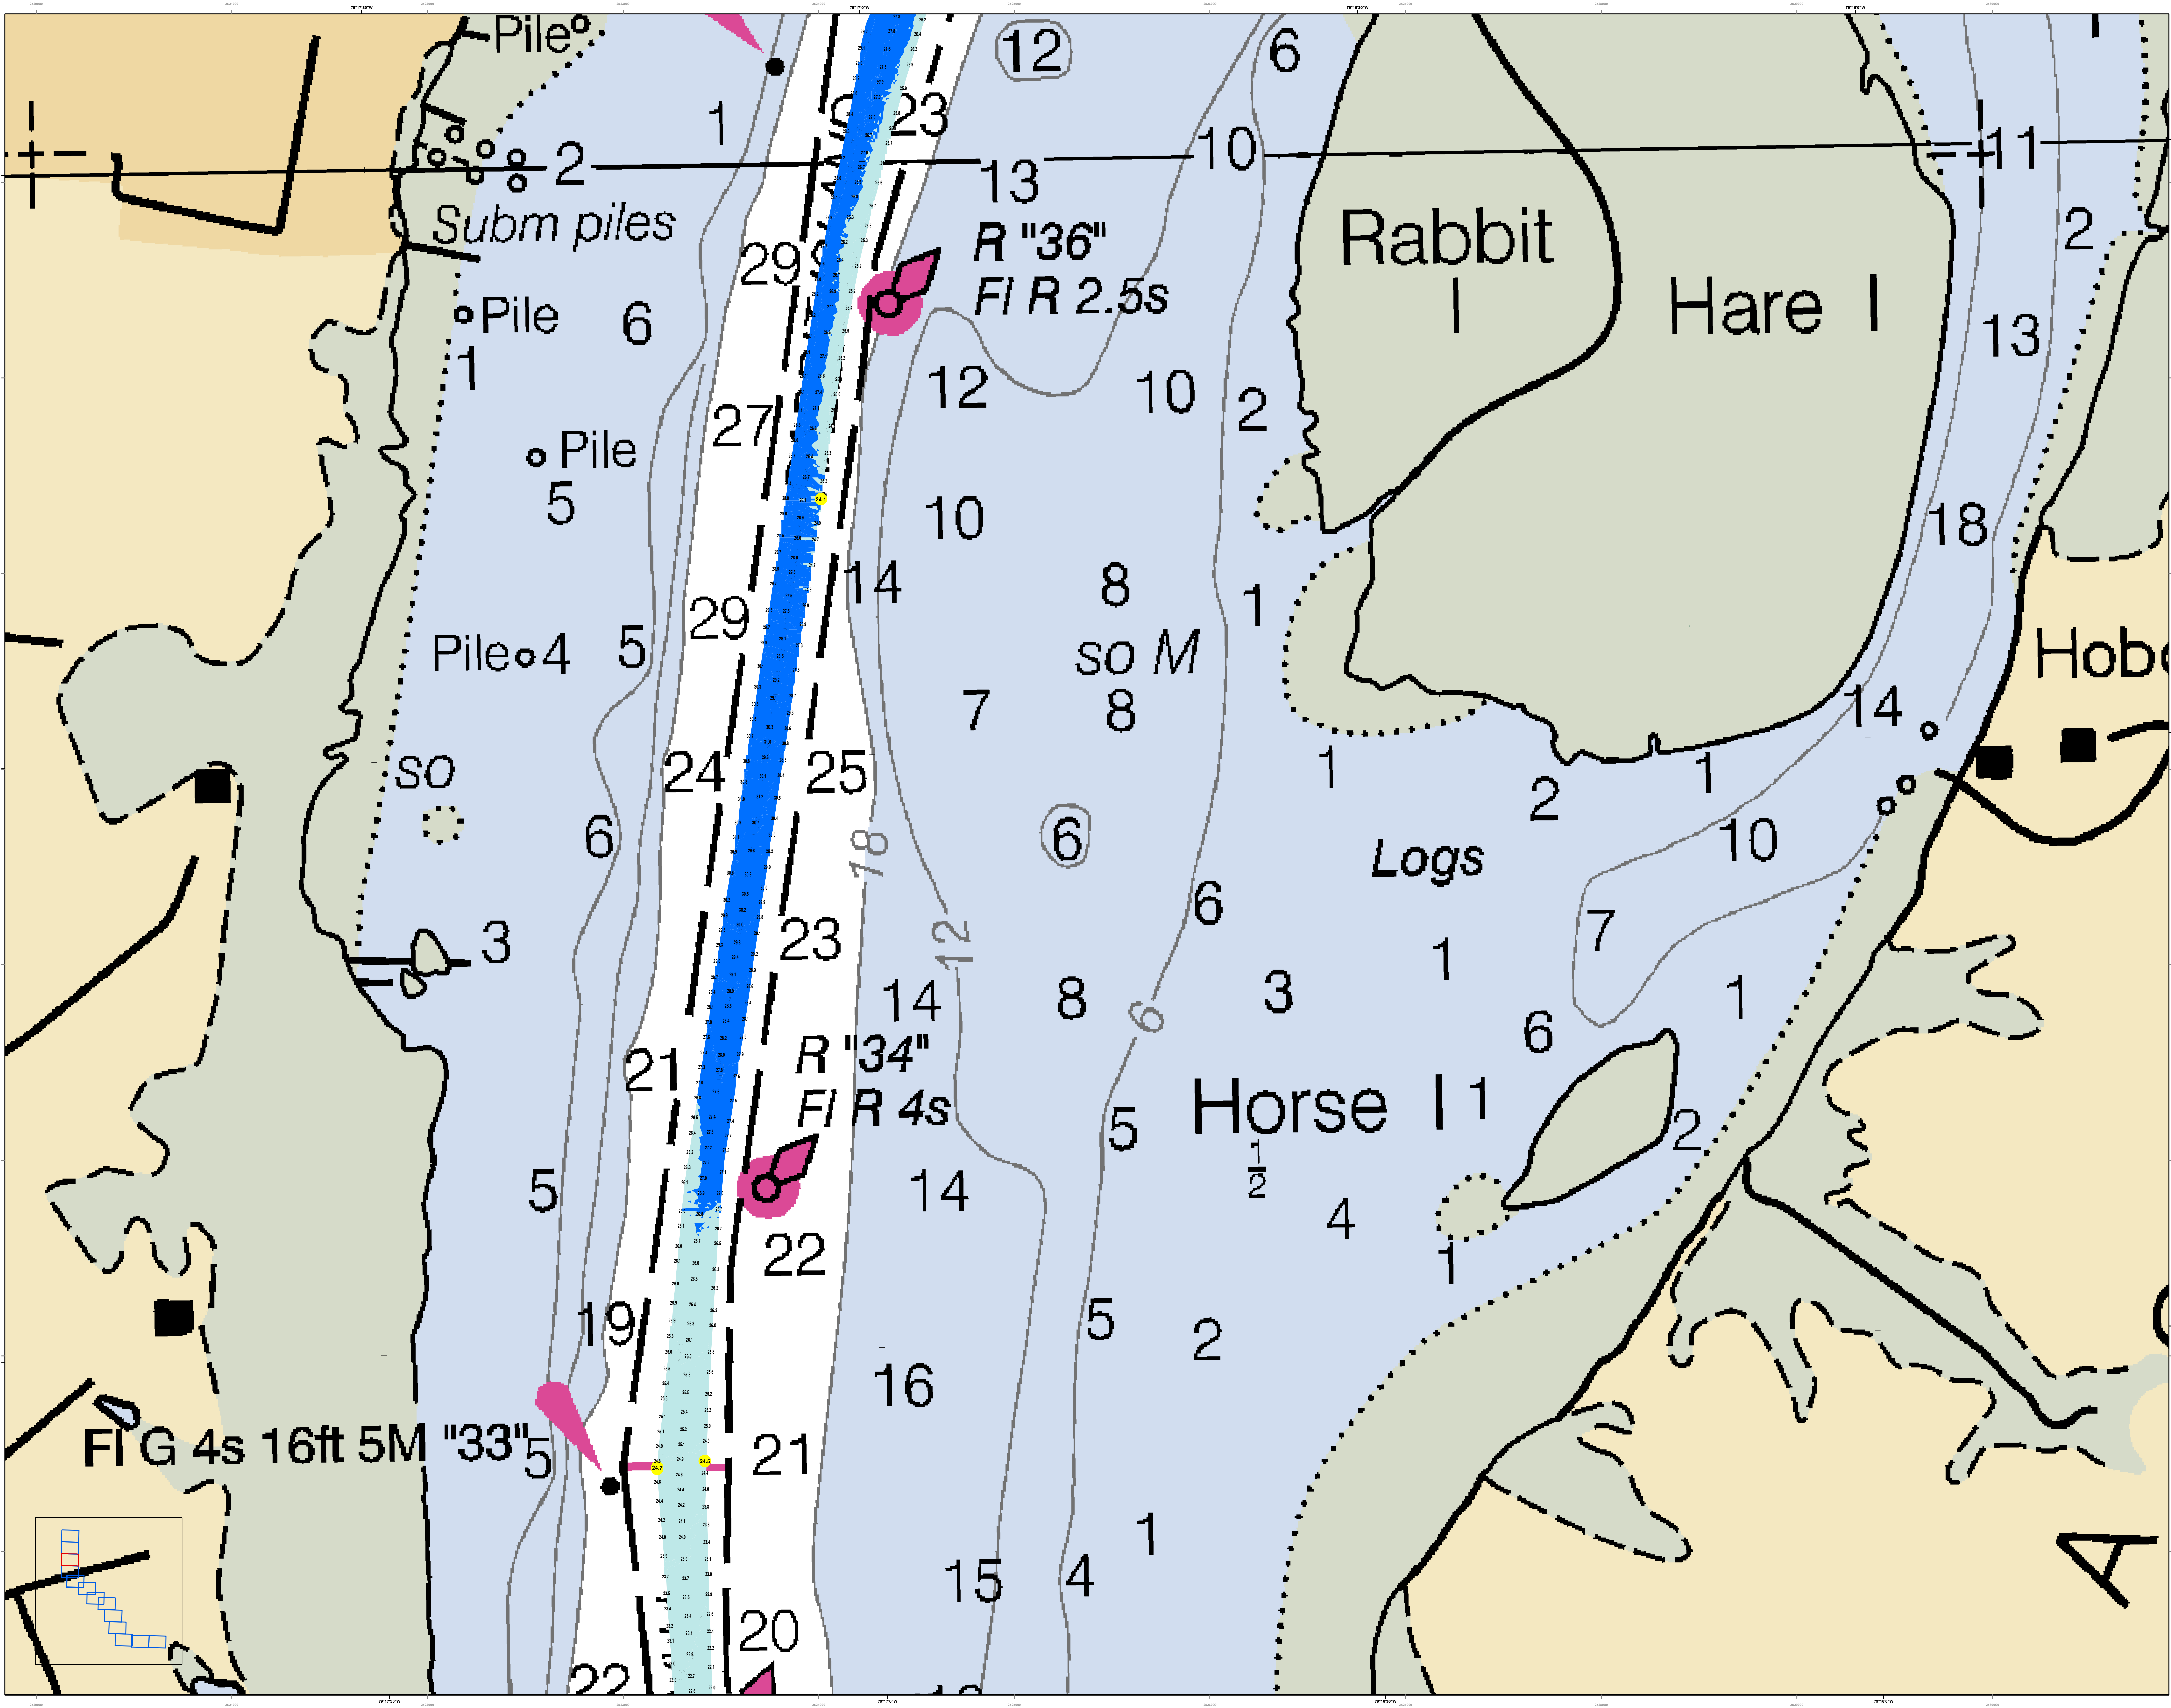

**U.S. Army Corps of Engineers**  
Charleston District


**Production Note:**  
1. This chart is a reproduction of the original hydrographic data and is not a substitute for the original data.  


Designed By:	U.S. Army Corps of Engineers	Produced By:	U.S. Army Corps of Engineers
Reviewed By:	U.S. Army Corps of Engineers	Project Reference Number:	15 AUG 2022
Scale:	1:25,000	Scale:	1:25,000
Projection:	NAD 1983 StatePlane South Carolina FIPS 3800 Feet	Projection:	NAD 1983 StatePlane South Carolina FIPS 3800 Feet

**Georgetown Harbor Channel Survey**  
The information depicted on this map represents the results of surveys made on the dates indicated and can only be considered as indicating the general character of the channel and shoals.  
Concluded on: 11 AUG 2022  
Georgetown, South Carolina

**SHEET REFERENCE NUMBER**  
C001  
SHEET 11 OF 13

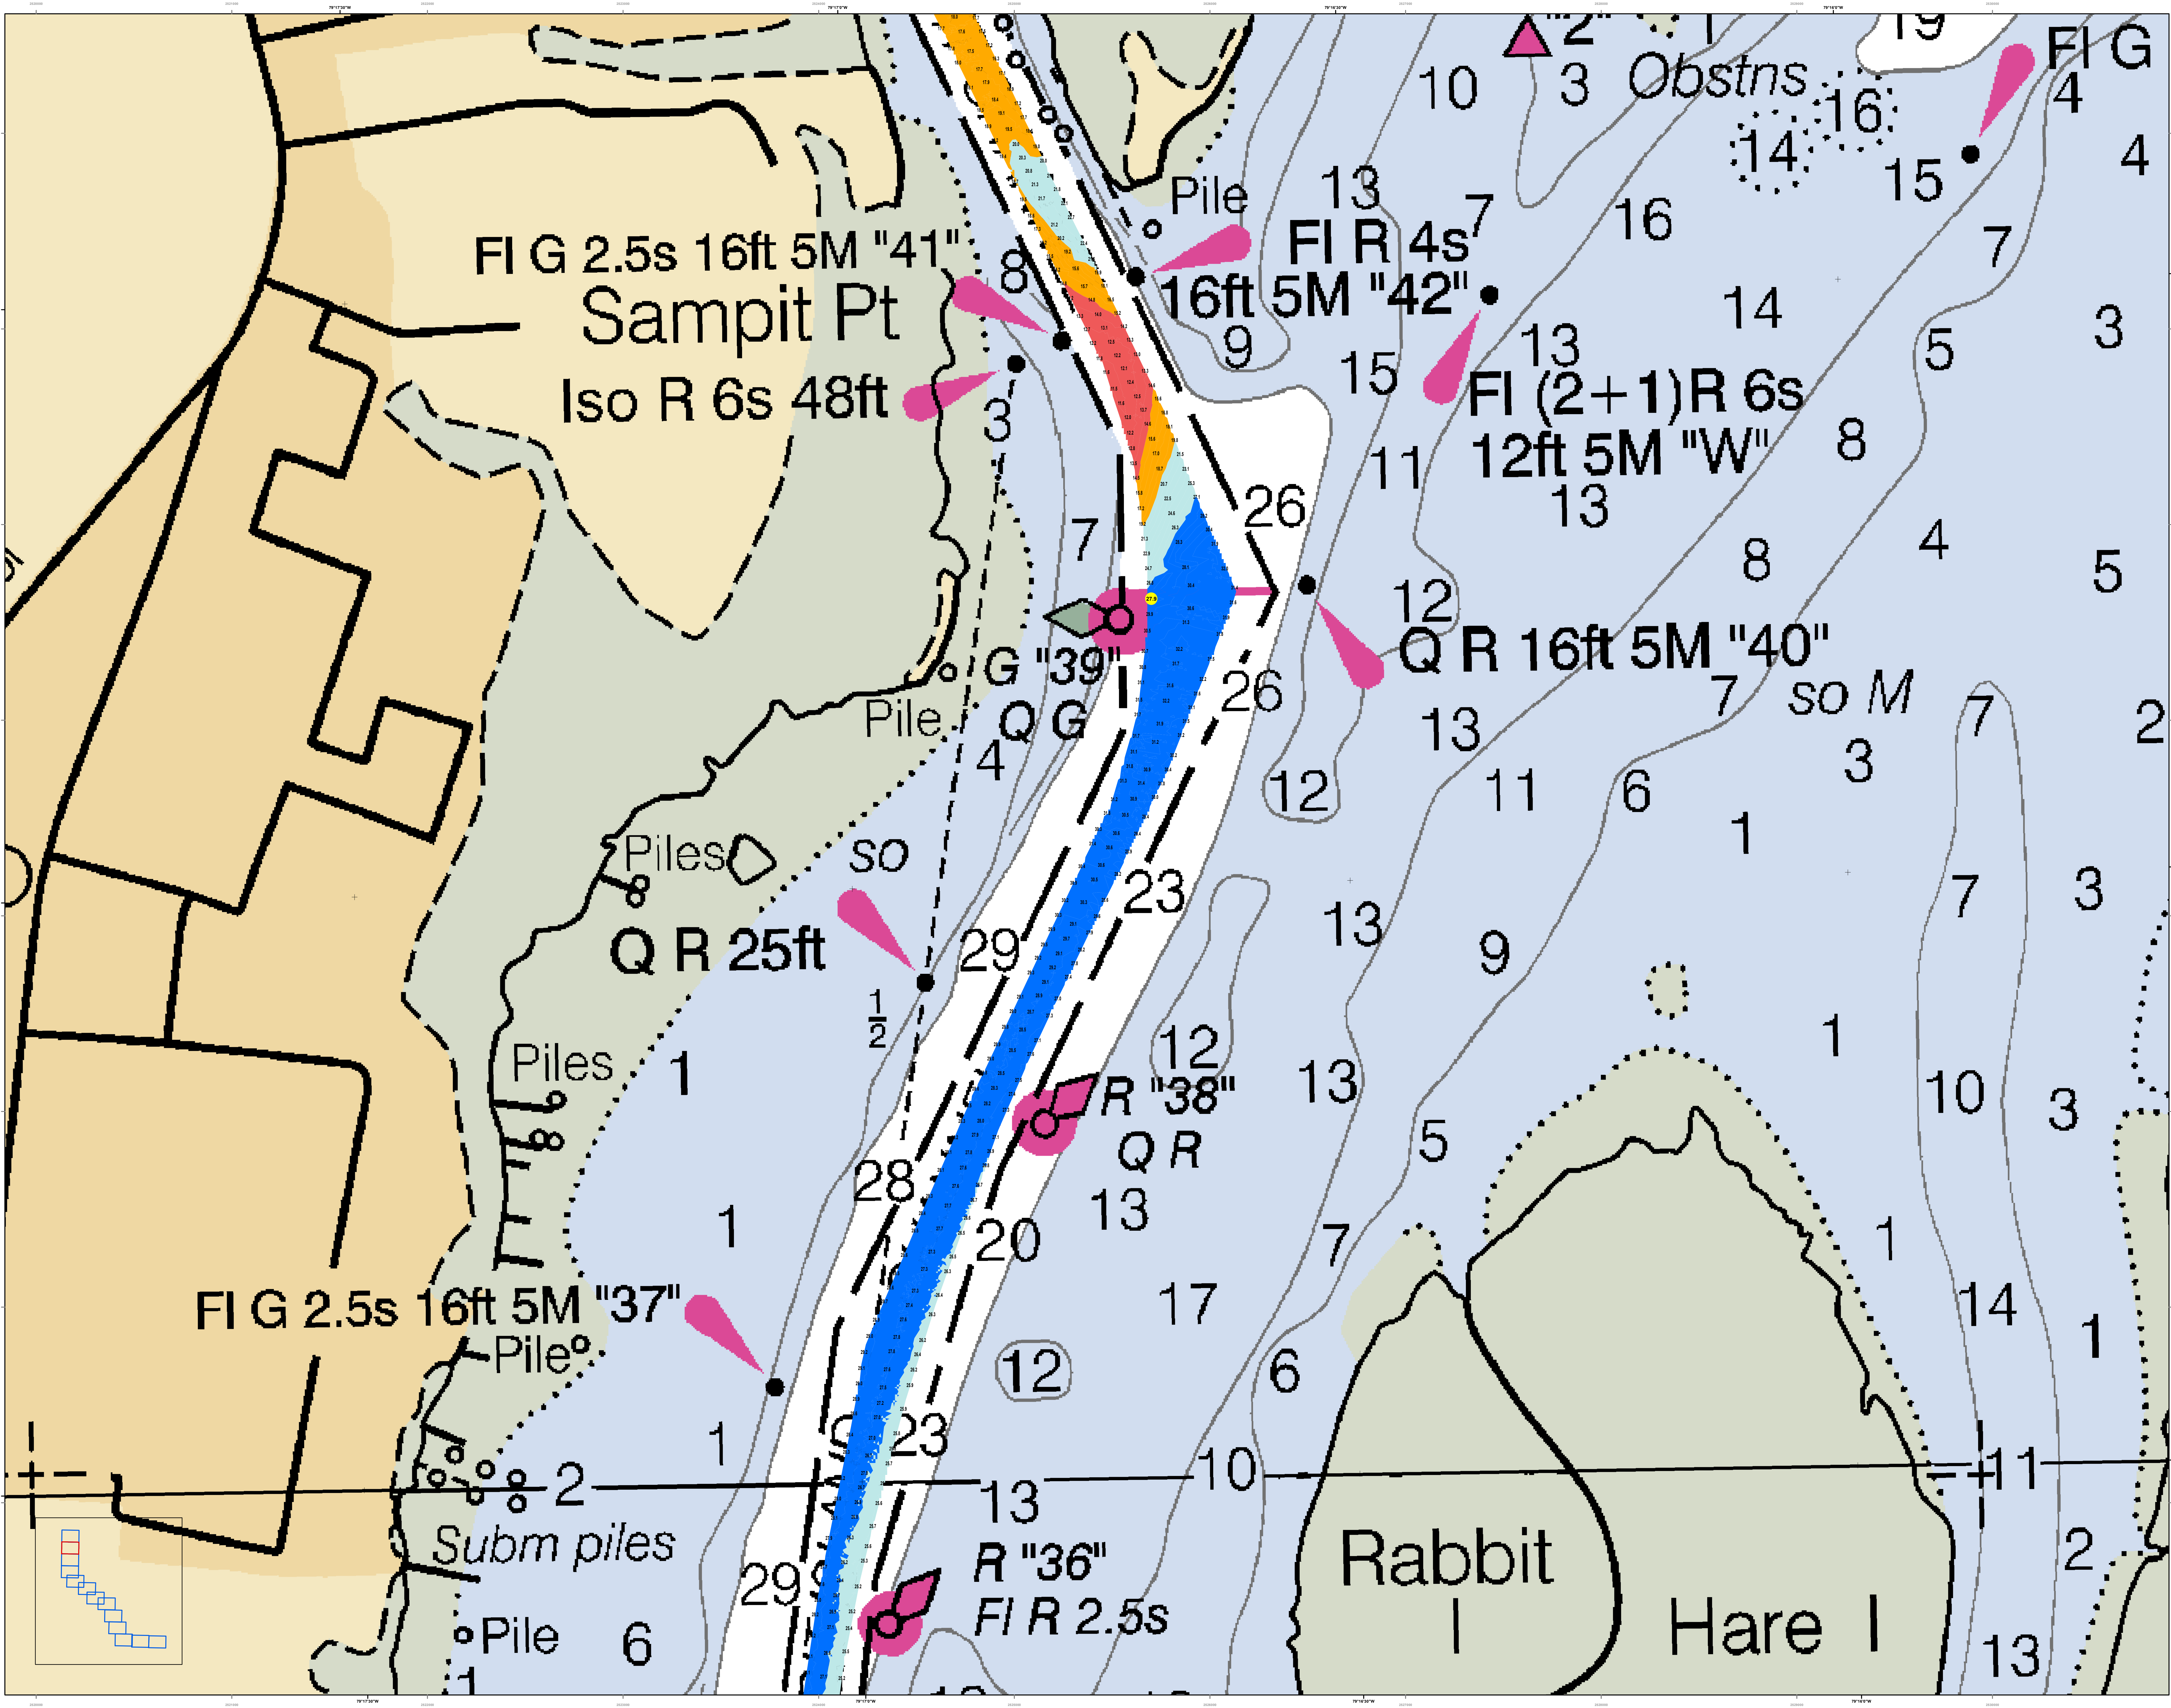

**Legend:**  
 Rabbit I  
 Hare I

**Scale:**  
 0 125 250 500 750 Feet

Designed By: jehydro	Software: v3.82	Survey Date: 11 AUG 2022	Production Date: 15 AUG 2022
Reviewed By: jehydro	Scale: 1:15,000	Project Reference Number: 16C001D	
Revised By: jehydro	Scale: 1 inch = 250 feet	Survey Station: CONDITION	
Project: MAD 1893 StatePlane South Carolina FPS 3800 Feet			

**Georgetown Harbor Channel Survey**  
 The information depicted on this map represents the results of surveys made on the dates indicated and can only be considered as indicating the general location of the objects shown.  
 Concluded on: 11 AUG 2022  
 Georgetown, South Carolina

